

# Registration Statement

## OF CLAIMANT OF RIGHT TO APPROPRIATE GROUND WATER

TO THE STATE ENGINEER OF OREGON:

I, W. J. Kloft  
(Mailing address)

State of Oregon, do hereby make application for a certificate of registration as evidence of a right to appropriate ground water.

1. Source from which water is withdrawn is from drilled well  
(Flowing well, pump well, infiltration trench, or tunnel)

2. Location is: 2 mi N.W. of Mt. Angel on Service road  
(Approximate distance and direction from nearest city or town)

and is more particularly described as follows: 20 feet east

(a) 254 chains south of the corner of Sec 2  
(Give distance and bearing to corner of section or other legal subdivision)

being within NW 1/4 of NW 1/4 of Sec. 2, Twp. 2, Rge. 1-W  
(Smallest legal subdivision) (N. or S.) (E. or W.)

or (b) within limits of recorded platted property, town or city:

in Lot \_\_\_\_\_ Block \_\_\_\_\_ of \_\_\_\_\_  
(Name of plat or addition)

(If within city or town, give name)

3. Construction Work was begun on Nov. 1939; was completed on Feb. 1940  
(Date) (Date)

and the ground water claimed was first used for the purposes set out below on June 1940  
(Date)

since which time the water has been used continuously  
(Continuously or intermittently)

from 1940 to 1954  
(Date) (Date)

4. Quantity of water claimed and used is about 150 gallons per minute; 0.167 acre feet per year.

5. Purpose or Purposes for which water is used pasture & Service  
(Domestic, irrigation, municipal, manufacturing, industrial, etc.)

6. Description of Well: Depth 73 feet. Type drilled  
(Dug or drilled)

diameter 2 inches. Elevation of ground at well site 145 feet, mean sea level  
(As near as known)

Depth to water table 2 feet.

7. Capacity of Well: undetermined g.p.m. with 15 feet drawdown.  
\_\_\_\_\_ g.p.m. with \_\_\_\_\_ feet drawdown.

Date of test as per actual working conditions

If Flowing Well: Measured discharge \_\_\_\_\_ g.p.m. on \_\_\_\_\_  
(Date)

Shut-in pressure at ground surface \_\_\_\_\_ lbs. per sq. in. on \_\_\_\_\_  
(Date)

Water is controlled by \_\_\_\_\_  
(Cap, valve, etc.)

8. Casing: (Give diameter, commercial specifications and depth below ground surface of each casing size.)

8 inch diameter CASING from 0 to 73 feet  
 inch diameter from to feet  
 inch diameter from to feet  
 inch diameter from to feet

Describe and show depth of shoe, plug, adapter, liner or other details:  
 .....  
 .....

9. Perforated Casings or Screens:

..... from ..... to .....  
 (Number per foot and size of perforations, or describe screen)  
 ..... from ..... to .....  
 ..... from ..... to .....  
 ..... from ..... to .....

10. Log of Well: (Describe each stratum or formation clearly, indicate if water bearing, and give thickness and depth as indicated.)

MATERIAL	Thickness (Feet)	Depth to Bottom (Feet)
ground all the way		
water about 70 ft. off		
real black sand then		
dropped into under ground		
lake bucket brought up		
agates & black & red rocks		
as found on the Oregon		
beaches water came to		
top of well.		

If log of well is not available, give name and address of driller. J. Ballerba

11. Infiltration Trench: Covered or open         
 Dimensions: Length        ft. Minimum depth        ft. Maximum depth        ft.  
 Bottom width        ft. Discharge        g.p.m. Date of test         
 12. Tunnel: Type of lining         
 Dimensions:         
(Length, course, and cross sectional size)  
 Position of water bearing stratum with reference to portal of tunnel       

Log of tunnel: (Preceding table for log of well may be used, if desired. Give footage from portal and character of materials, as pertinent.)


13. Pumping Equipment:  
 (a) Pump Jacuzzi Turbine Capacity 150 g.p.m.  
(Make, type and size)  
 (b) Motor 5HP  
(Type and horsepower)

14. Location of area irrigated or to be irrigated, or place of use if for purposes other than irrigation.

Township North or South	Range E. or W. of Willamette Meridian	Section	Forty-acre Tract	Number Acres To Be Irrigated	Date of Reclamation
65	1W	4	NW 1/4 of NW 1/4	25	June 1940
65	1W	5	NE 1/4 of NE 1/4	8	Aug. 1958
				33	

15. If the ground water supply is supplemental to an existing water supply, identification of any application for a permit, permit, certificate or adjudicated right to appropriate water made or held by the registrant.

Township T. 6 S Range R. 1 W. W.M.  
 North 34° 30' 00" E

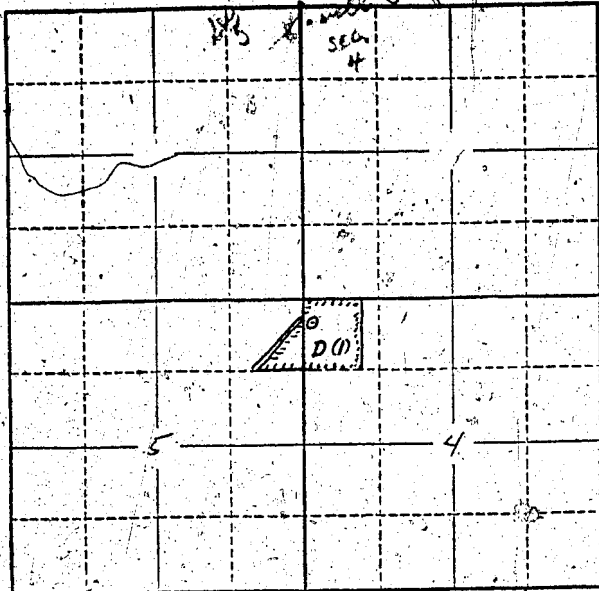

South 65th  
 line from  
 the north  
 west corner  
 of Sec.  
 then east  
 3 chains

Locate well and acreage of irrigated land on plat.  
 Scale: 2" = 1 Mile

STATE OF OREGON


I, W. J. Kraft, being first duly sworn, do hereby certify that I have read the foregoing Registration Statement and that all of the items therein contained are true to the best of my knowledge and belief.

W. J. Kraft  
 (Signature of Registrant)

Subscribed and sworn to before me this 15th day of June, 1957.

My commission expires June 12, 1961 Wm. D. Bartholomew  
 (Notary Public)

(SEAL)

**CERTIFICATE OF REGISTRATION**

STATE OF OREGON } ss.  
 County of Marion

This is to certify that the foregoing Registration Statement was received in the office of the State Engineer on the 15th day of July, 1957, at 8:00 o'clock A. M. and has been duly recorded in said office in Book No. 3 of Registration Statements on page GR-525-C

Witness my hand this 13th day of September, 1957.

[Signature]  
 (State Engineer)

By \_\_\_\_\_ (Deputy)