

# Registration Statement

## OF CLAIMANT OF RIGHT TO APPROPRIATE GROUND WATER

TO THE STATE ENGINEER OF OREGON:

I, Tyler J. Ferris  
of 390 Santa Clara Ave, Eugene County of Lane  
(Mailing address)

State of Oregon, do hereby make application for a certificate of registration as evidence of a right to appropriate ground water.

1. Source from which water is withdrawn is Tunnel Well  
(Flowing well, pump well, infiltration trench, or tunnel)

2. Location is: Three + one half miles North of Eugene, Ore.  
(Approximate distance and direction from nearest city or town)

and is more particularly described as follows:

(a) Tract in S. 11, T. 17 S., R. 4 W., W.M. and 24  
(Give distance and bearing to corner of section or other legal subdivision)

being within \_\_\_\_\_ of Sec. \_\_\_\_\_, Twp. \_\_\_\_\_, Rge. \_\_\_\_\_  
(Smallest legal subdivision) (N. or S.) (E. or W.)

or (b) within limits of recorded platted property, town or city:

in Lot 10, Block \_\_\_\_\_ of Bakers Addition, Santa Clara  
(Name of plat or addition)

County of Lane  
(If within city or town, give name)

3. Construction Work was begun on 8/1951; was completed on 9/1951  
(Date) (Date)

and the ground water claimed was first used for the purposes set out below on 9/1951  
(Date)

since which time the water has been used Continuously  
(Continuously or Intermittently)

from April 1954 to Present  
(Date) (Date)

4. Quantity of water claimed and used is 320 gallons per minute; 22 1/2 acre feet per year.

5. Purpose or Purposes for which water is used Irrigation to grow alfalfa

~~Domestic, irrigation, municipal, manufacturing, industrial, etc.~~

6. Description of Well: Depth 200 feet. Type Drilled  
(Dug or drilled)

diameter 4 inches. Elevation of ground at well site 350 feet, mean sea level.  
(As near as known)

Depth to water table 24 feet.

7. Capacity of Well: \_\_\_\_\_ g.p.m. with \_\_\_\_\_ feet drawdown.  
\_\_\_\_\_ g.p.m. with \_\_\_\_\_ feet drawdown.

Date of test Not tested

If Flowing Well: Measured discharge \_\_\_\_\_ g.p.m. on not flowing well  
(Date)


Shut-in pressure at ground surface \_\_\_\_\_ lbs. per sq. in. on \_\_\_\_\_  
(Date)

Water is controlled by \_\_\_\_\_  
(Cap, valve, etc.)





Township 17S Range 4 W., W.M.  
North

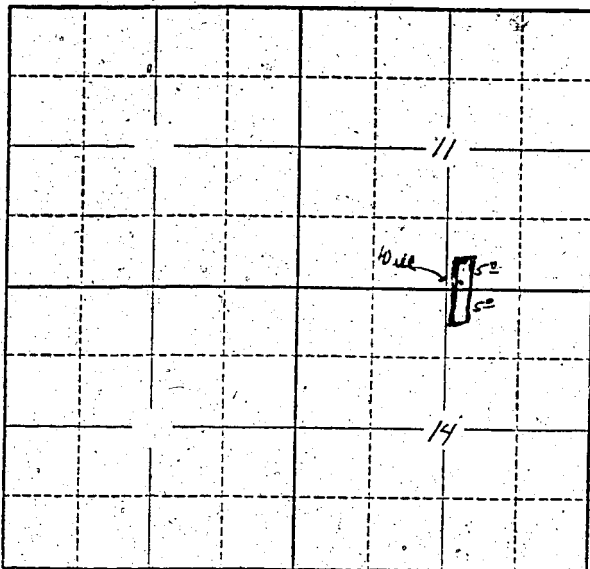

Locate well and acreage of irrigated land on plat.

Scale: ~~1/4~~ - 1 Mile

4

STATE OF OREGON

County of LANE

} ss.

I, TYLER J. FENN, being first duly sworn, do hereby certify that I have read the foregoing Registration Statement and that all of the items therein contained are true to the best of my knowledge and belief.

*Tyler J. Fenn*  
(Signature of Registrant)

Subscribed and sworn to before me this 15th day of July, 1957.

My commission expires April 26, 1961.

*Thomas P. Henderson*

(Notary Public) for Oregon

(SEAL)

**CERTIFICATE OF REGISTRATION**

STATE OF OREGON

County of Marion

} ss.

This is to certify that the foregoing Registration Statement was received in the office of the State Engineer on the 22 day of July, 1957, at 8:00 o'clock A. M. and has been duly recorded in said office in Book No. 7 of Registration Statements on page .....

Witness my hand this 1st day of December, 1958

*Laura A. Stanley*  
(State Engineer)

By .....

(Deputy)

\$15.00

GR 1564