

# Registration Statement

## OF CLAIMANT OF RIGHT TO APPROPRIATE GROUND WATER

TO THE STATE ENGINEER OF OREGON:

I, Herbert Brown

of Route 4, Box 352, Corvallis County of Benton  
(Mailing address)

State of Oregon do hereby make application for a certificate of registration as evidence of a right to appropriate ground water.

1. Source from which water is withdrawn is pump well #1  
(Flowing well, pump well, infiltration trench, or tunnel)

2. Location is: 3 1/2 miles SE of Corvallis  
(Approximate distance and direction from nearest city or town)

and is more particularly described as follows: S 39° 52' W 1875.39 ft. from government survey point located on township line 12S between ranges 14W and 5W WM

(a) NW 1/4 of NE 1/4  
(Give distance and bearing to corner of section or other legal subdivision)

being within NW 1/4 of NE 1/4 of Sec. 2, Twp. 12S, Rge. 5W  
(Smallest legal subdivision) (N. or S.) (E. or W.)

or (b) within limits of recorded platted property, town or city:  
in Lot \_\_\_\_\_, Block \_\_\_\_\_ of \_\_\_\_\_  
(Name of plat or addition)

County of \_\_\_\_\_  
(If within city or town, give name)

3. Construction Work was begun on April, 1953; was completed on April, 1953  
(Date) (Date)

and the ground water claimed was first used for the purposes set out below on April, 1953  
(Date)

since which time the water has been used continuously  
(Continuously or intermittently)

from April, 1953 to 1957  
(Date) (Date)

4. Quantity of water claimed and used is 563 gallons per minute; 200 acre feet per year.

5. Purpose or Purposes for which water is used domestic irrigation

(Domestic, irrigation, municipal, manufacturing, industrial, etc.)

6. Description of Well: Depth 30 feet. Type drilled  
(Dug or drilled)

diameter 12 inches. Elevation of ground at well site 218 feet, mean sea level.  
(As near as known)

Depth to water table 11 feet.

7. Capacity of Well: 800 g.p.m. with 19 feet drawdown.

\_\_\_\_\_ g.p.m. with \_\_\_\_\_ feet drawdown.

Date of test April, 1953

If Flowing Well: Measured discharge \_\_\_\_\_ g.p.m. on \_\_\_\_\_  
(Date)

Shut-in pressure at ground surface \_\_\_\_\_ lbs. per sq. in. on \_\_\_\_\_  
(Date)

Water is controlled by \_\_\_\_\_  
(Cap, valve, etc.)

8. Casing: (Give diameter, commercial specifications and depth below ground surface of each casing size.)

Boxed pit from surface to 7 feet

12 inch diameter steel casing from 7 to 30 feet  
 ..... inch diameter ..... from ..... to ..... feet  
 ..... inch diameter ..... from ..... to ..... feet  
 ..... inch diameter ..... from ..... to ..... feet

Describe and show depth of shoe, plug, adapter, liner or other details: .....

9. Perforated Casings or Screens:

Slotted, exact size and position unknown from ..... to .....  
(Number per foot and size of perforations, or describe screen)  
 ..... from ..... to .....  
 ..... from ..... to .....  
 ..... from ..... to .....

10. Log of Well: (Describe each stratum or formation clearly, indicate if water bearing, and give thickness and depth as indicated.)

MATERIAL	Thickness (Feet)	Depth to Bottom (Feet)
silt to 5'		
sand from 5' to 16'		
gravel 16' to 30'		

If log of well is not available, give name and address of driller. ....

11. Infiltration Trench: Covered or open .....  
 Dimensions: Length ..... ft. Minimum depth ..... ft. Maximum depth ..... ft.  
 Bottom width ..... ft. Discharge ..... g.p.m. Date of test .....

12. Tunnel: Type of lining .....  
 Dimensions: .....  
(Length, course, and cross sectional size)  
 Position of water bearing stratum with reference to portal of tunnel .....

Log of tunnel: (Preceding table for log of well may be used, if desired. Give footage from portal and character of materials, as pertinent.)


13. Pumping Equipment:  
 (a) Pump Morse centrifugal 3 x 4 ..... Capacity 550 ..... g.p.m.  
(Make, type and size)  
 (b) Motor 25 h.p. 3 phase electric .....  
(Type and horsepower)

14. Location of area irrigated or to be irrigated, or place of use if for purposes other than irrigation.

Township North or South	Range E. or W. of Willamette Meridian	Section	Forty-acre Tract	Number Acres To Be Irrigated	Date of Reclamation
			166		
12S	5W	12	NE 1/4	98.75 Total	1953
12S	4W	7	NE 1/4, NW 1/4	1.25	1953
"	5W	12	NE 1/4 of NE 1/4	34.75	"
"	5W	12	NW 1/4 of NE 1/4	18.00	"
"	5W	12	SE 1/4 of NE 1/4	15.00	"
"	5W	12	SW 1/4 of NE 1/4	32.00	"
				100.00 AC.	

15. If the ground water supply is supplemental to an existing water supply, identification of any application for a permit, permit, certificate or adjudicated right to appropriate water made or held by the registrant.

Township 125 Range 5 11, W.M.  
North

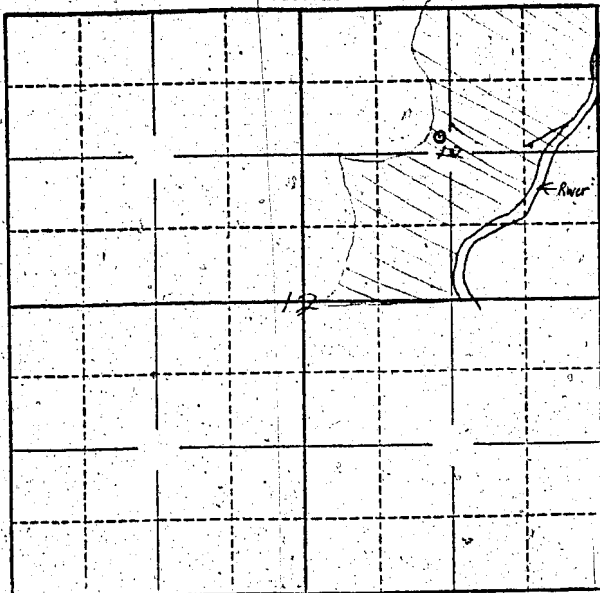

Locate well and acreage of irrigated land on plat.  
Scale: 2" = 1 Mile

STATE OF OREGON

County of Marion } ss.

I, Herbert R. Brown, being first duly sworn, do hereby certify that I have read the foregoing Registration Statement and that all of the items therein contained are true to the best of my knowledge and belief.

Herbert R. Brown  
(Signature of Registrant)

Subscribed and sworn to before me this 22nd day of July, 1957.

My commission expires June 12th, 1961 Wm. S. Bartholomew  
(Notary Public)

(SEAL)

**CERTIFICATE OF REGISTRATION**

STATE OF OREGON

County of Marion } ss.

This is to certify that the foregoing Registration Statement was received in the office of the State Engineer on the 22nd day of July, 1957 at 10:30 o'clock A. M. and has been duly recorded in said office in Book No. 3 of Registration Statements on page GR-528 C.

Witness my hand this 13th day of September, 1957.

Lewis A. Blaine  
(State Engineer)

By \_\_\_\_\_ (Deputy)

GR - 528 C

#2550