

RECEIVED

JUL 20 1957

Registration Statement

STATE ENGINEER

SALEM, OREGON CLAIMANT OF RIGHT TO APPROPRIATE GROUND WATER

TO THE STATE ENGINEER OF OREGON:

I, Minerva M. and Homer W. Lively  
of 3750 Wilton Ave - Salem County of Marion  
(Mailing address)

State of Oregon do hereby make application for a certificate of registration as evidence of a right to appropriate ground water.

1. Source from which water is withdrawn is well Pump  
(Flowing well, pump well, infiltration trench, or tunnel)

2. Location is: 8 1/2 miles north and west of Salem  
(Approximate distance and direction from nearest city or town)

and is more particularly described as follows: 265'S 4 110'E from NW corner Section 25

(a) 1/4 mile N 1/2 mile W 1/4 mile S of T. Scamner 25  
(Give distance and bearing to corner of section or other legal subdivision)

being within NW 1/4 NE 1/4 of Sec. 25, Twp. 6S, Rge. 4W  
(Smallest legal subdivision) (N. or S.) (E. or W.)

or (b) within limits of recorded platted property, town or city:

in Lot \_\_\_\_\_, Block \_\_\_\_\_ of \_\_\_\_\_  
(Name of plat or addition)

County of Poke  
(If within city or town, give name)

3. Construction Work was begun on April 1 1952; was completed on April 15<sup>th</sup> 1952  
(Date) (Date)

and the ground water claimed was first used for the purposes set out below on July 1952  
(Date)

since which time the water has been used Intermittently  
(Continuously or Intermittently)

from July 1952 to Sept 30<sup>th</sup>  
(Date) (Date)

4. Quantity of water claimed and used is 180 gallons per minute; 1.9 acre feet per year.

5. Purpose or Purposes for which water is used Irrigation of Pasture

(Domestic, irrigation, municipal, manufacturing, industrial, etc.)

6. Description of Well: Depth 117 feet. Type drilled  
(Dug or drilled)

diameter 6 in inches. Elevation of ground at well site 220 feet, mean sea level.  
(As near as known)

Depth to water table 15 feet.

7. Capacity of Well: \_\_\_\_\_ g.p.m. with \_\_\_\_\_ feet drawdown.  
\_\_\_\_\_ g.p.m. with \_\_\_\_\_ feet drawdown.

Date of test unknown

If Flowing Well: Measured discharge \_\_\_\_\_ g.p.m. on \_\_\_\_\_  
(Date)

Shut-in pressure at ground surface \_\_\_\_\_ lbs. per sq. in. on \_\_\_\_\_  
(Date)

Water is controlled by Pumping  
(Cap, valve, etc.)

8. Casing: (Give diameter, commercial specifications and depth below ground surface of each casing size.)

6 inch diameter 6 in from surface to 94 feet  
 ..... inch diameter ..... from ..... to ..... feet  
 ..... inch diameter ..... from ..... to ..... feet  
 ..... inch diameter ..... from ..... to ..... feet

Describe and show depth of shoe, plug, adapter, liner or other details: .....

9. Perforated Casings or Screens:

..... from ..... to .....

(Number per foot and size of perforations, or describe screen)

..... from ..... to .....

..... from ..... to .....

..... from ..... to .....

10. Log of Well: (Describe each stratum or formation clearly, indicate if water bearing, and give thickness and depth as indicated.)

MATERIAL	Thickness (Feet)	Depth to Bottom (Feet)
Soil Clay	15	
Rock	15	
Sandy shale		

If log of well is not available, give name and address of driller. ....

X 11. Infiltration Trench: Covered or open Covered  
 Dimensions: Length ..... ft. Minimum depth ..... ft. Maximum depth 117 ft.  
 Bottom width ..... ft. Discharge ..... g.p.m. Date of test .....

X 12. Tunnel: Type of lining Solid Casing  
 Dimensions: 6 in  
(Length, course, and cross sectional size)  
 Position of water bearing stratum with reference to portal of tunnel .....

Log of tunnel: (Preceding table for log of well may be used, if desired. Give footage from portal and character of materials, as pertinent.)


13. Pumping Equipment:  
 (a) Pump ..... Capacity ..... g.p.m.  
(Make, type and size)  
 (b) Motor Electric ..... 5 H P  
(Type and horsepower)

14. Location of area irrigated or to be irrigated, or place of use if for purposes other than irrigation.

Township North or South	Range E. or W. of Willamette Meridian	Section	Forty-acre Tract	Number Acres To Be Irrigated	Date of Reclamation
<del>6 S</del>	<del>4 W</del>	<del>24</del>	<del>SW 1/4 SE 1/4</del>	<del>19 a</del>	<del>April 1952</del>
6 S	4 W	24	SW 1/4 SE 1/4	19 a	April 1952

15. If the ground water supply is supplemental to an existing water supply, identification of any application for a permit, permit, certificate or adjudicated right to appropriate water made or held by the registrant.

Township 6 S Range 4 W W.M. North

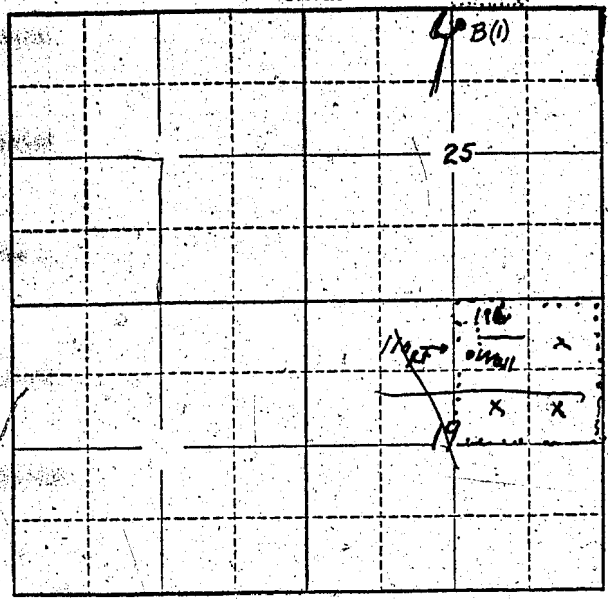

Locate well and acreage of irrigated land on plat.  
Scale: 2" = 1 Mile

STATE OF OREGON }  
County of Marion } ss.

I, Homer W. Lisensby, being first duly sworn, do hereby certify that I have read the foregoing Registration Statement and that all of the items therein contained are true to the best of my knowledge and belief.

Homer W. Lisensby  
(Signature of Registrant)

Subscribed and sworn to before me this 26th day of July, 1957.

My commission expires 9/27/58

Jeanie Baster  
(Notary Public)

(SEAL)

**CERTIFICATE OF REGISTRATION**

STATE OF OREGON }  
County of Marion } ss.

This is to certify that the foregoing Registration Statement was received in the office of the State Engineer on the 26th day of July, 1957, at 8:30 o'clock A. M. and has been duly recorded in said office in Book No. 4 of Registration Statements on page GR-585 C.

Witness my hand this 16th day of October, 1957.

Clara A. Stanley  
(State Engineer)

By \_\_\_\_\_  
(Deputy)

#1500