

Registration Statement

OF CLAIMANT OF RIGHT TO APPROPRIATE GROUND WATER

TO THE STATE ENGINEER OF OREGON:

I, Harold Chance

of Post Office Box 669, Corvallis County of Benton
(Mailing address)

State of Oregon, do hereby make application for a certificate of registration as evidence of a right to appropriate ground water.

1. Source from which water is withdrawn is pumpwell
(Flowing well, pump well, infiltration trench, or tunnel)

2. Location is: 3 mile North of Corvallis
(Approximate distance and direction from nearest city or town)

and is more particularly described as follows: (Approx.) 2860 feet west and 2300 feet south from NE corner Section 19

(a) 100' N 70° W, 30' S 20° W from E property corner
(Give distance and Bearing to corner of section or other legal subdivision)

being within S.E. 1/4 of NW 1/4 of Sec. 19, Twp. 11, Rge. 4W
(Smallest legal subdivision) (N. or S.) (E. or W.)

or (b) within limits of recorded platted property, town or city:

in Lot _____, Block _____ of _____
(Name of plat or addition)

County of _____
(If within city or town, give name)

3. Construction Work was begun on prior to 1955; was completed on prior to 1955
(Date) (Date)

and the ground water claimed was first used for the purposes set out below on prior to 1955
(Date)

since which time the water has been used continuously
(Continuously or intermittently)

from date prior to 1955 6-57
(Date) (Date)

4. Quantity of water claimed and used is 35 gallons per minute; 1.2 acre feet per year.

5. Purpose or Purposes for which water is used domestic irrigation

(Domestic, irrigation, municipal, manufacturing, industrial, etc.)

6. Description of Well: Depth 40 feet. Type drilled
(Dug or drilled)

diameter 6 inches. Elevation of ground at well site 215 feet, mean sea level.
(As near as known)

Depth to water table 25 feet.

7. Capacity of Well: unknown g.p.m. with _____ feet drawdown.

_____ g.p.m. with _____ feet drawdown.

Date of test _____

If Flowing Well: Measured discharge _____ g.p.m. on _____
(Date)

Shut-in pressure at ground surface _____ lbs. per sq. in. on _____
(Date)

Water is controlled by _____
(Cap, valve, etc.)

8. Casing: (Give diameter, commercial specifications and depth below ground surface of each casing size.)

6 inch diameter steel from surface to unknown feet
..... inch diameter from to feet
..... inch diameter from to feet
..... inch diameter from to feet

Describe and show depth of shoe, plug, adapter, liner or other details:

9. Perforated Casings or Screens:

unknown from to
(Number per foot and size of perforations, or describe screen)
..... from to
..... from to
..... from to

10. Log of Well: (Describe each stratum or formation clearly, indicate if water bearing, and give thickness and depth as indicated.)

MATERIAL	Thickness (Feet)	Depth to Bottom (Feet)
unknown	unknown	

If log of well is not available, give name and address of driller. unknown

11. Infiltration Trench: Covered or open

Dimensions: Length ft. Minimum depth ft. Maximum depth ft.

Bottom width ft. Discharge g.p.m. Date of test

12. Tunnel: Type of lining

Dimensions:
(Length, course, and cross sectional size)

Position of water bearing stratum with reference to portal of tunnel

Log of tunnel: (Preceding table for log of well may be used, if desired. Give footage from portal and character of materials, as pertinent.)

13. Pumping Equipment:

(a) Pump Jacuzzi 3VHH Turbine Capacity 50 g.p.m.
(Make, type and size)

(b) Motor 3 horsepower, 3 phase electric
(Type and horsepower)


14. Location of area irrigated or to be irrigated, or place of use if for purposes other than irrigation.

Township North or South	Range E. or W. of Willamette Meridian	Section	Forty-acre Tract	Number Acres To Be Irrigated	Date of Reclamation
11S	4W	19	SE 1/4 NW 2	3.5	prior to 1955

15. If the ground water supply is supplemental to an existing water supply, identification of any application for a permit, permit, certificate or adjudicated right to appropriate water made or held by the registrant.


North

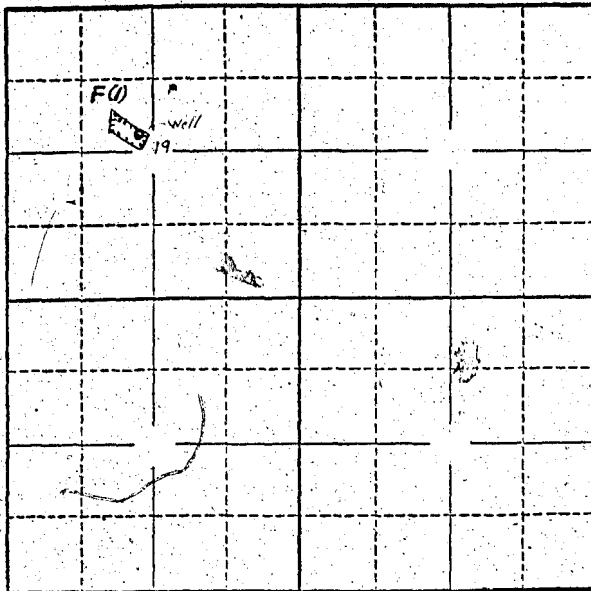

Locate well and acreage of irrigated land on plat.

Scale: 2" = 1 Mile

STATE OF OREGON

County of Deschutes } ss.

I, Harold Chance, being first duly sworn, do hereby certify that I have read the foregoing Registration Statement and that all of the items therein contained are true to the best of my knowledge and belief.

Harold Chance
(Signature of Registrant)

Subscribed and sworn to before me this 23rd day of July, 1957.

My commission expires My Commission Expires March 28, 1961
A. Rene Wells
(Notary Public)

(SEAL)

CERTIFICATE OF REGISTRATION

STATE OF OREGON }
County of Marion } ss.

This is to certify that the foregoing Registration Statement was received in the office of the State Engineer on the 29th day of July, 1957, at 8:00 o'clock A. M. and has been duly recorded in said office in Book No. 3 of Registration Statements on page GR-530 C.

Witness my hand this 13th day of September, 1957.

Lewis A. Standen
(State Engineer)

\$15.00

By _____
(Deputy)