

Registration Statement

OF CLAIMANT OF RIGHT TO APPROPRIATE GROUND WATER

TO THE STATE ENGINEER OF OREGON:

I, R. L. and Rova Wirth or survivor of either

of Tangent County of Linn

(Mailing address)

State of Oregon, do hereby make application for a certificate of registration as evidence of a right to appropriate ground water.

1. Source from which water is withdrawn is pump well

(Flowing well, pump well, infiltration trench, or tunnel)

2. Location is: 5 miles SE of Tangent, Oregon

(Approximate distance and direction from nearest city or town)

and is more particularly described as follows:

(a) N. 32° 10' W. 9 chains from SE corner of SW $\frac{1}{4}$ of S. 29, T. 12 S., R. 3 W.

(Give distance and bearing to corner of section or other legal subdivision)

being within SE $\frac{1}{4}$ of SW $\frac{1}{4}$ of Sec. 29, Twp. 12 S., Rge. 3 W.

(Smallest legal subdivision)

(N. or S.)

(E. or W.)

or (b) within limits of recorded platted property, town or city:

in Lot _____, Block _____ of _____

(Name of plat or addition)

County of Linn

(If within city or town, give name)

3. Construction Work was begun on April, 1952; was completed on May, 1952

(Date)

(Date)

and the ground water claimed was first used for the purposes set out below on May, 1953

(Date)

since which time the water has been used continuously

(Continuously or intermittently)

from May, 1953 to present time

(Date)

(Date)

4. Quantity of water claimed and used is 160 gallons per minute; 77.5 acre feet per year.

5. Purpose or Purposes for which water is used Irrigation

(Domestic, irrigation, municipal, manufacturing, industrial, etc.)

6. Description of Well: Depth 106 feet. Type Drilled

(Dug or drilled)

diameter 10 inches. Elevation of ground at well site 250 feet, mean sea level.

(As near as known)

Depth to water table 30 feet.

7. Capacity of Well: 280 g.p.m. with 50 feet drawdown.

_____ g.p.m. with _____ feet drawdown.

Date of test May, 1953

If Flowing Well: Measured discharge _____ g.p.m. on _____

(Date)

Shut-in pressure at ground surface _____ lbs. per sq. in. on _____

(Date)

Water is controlled by _____

(Cap, valve, etc.)

8. Casing: (Give diameter, commercial specifications and depth below ground surface of each casing size.)

10 inch diameter steel casing from 0 to 106 feet
 inch diameter from to feet
 inch diameter from to feet
 inch diameter from to feet

Describe and show depth of shoe, plug, adapter, liner or other details:

9. Perforated Casings or Screens:

Slot perforations from 30 to 35
 (Number per foot and size of perforations, or describe screen)
 " from 50 to 55
 " from 65 to 70
 " from 80 to 80
 " 100 108

10. Log of Well: (Describe each stratum or formation clearly, indicate if water bearing, and give thickness and depth as indicated.)

MATERIAL	Thickness (Feet)	Depth to Bottom (Feet)
Not available		

224-443 *with*

Beginning at the Southeast corner of the South west quarter of Section 29, T. 12 S., R. 3 W. of the Will. Mer. in Linn County, Oregon, on the West line of a tract conveyed to A. R. Foster and wife by deed recorded Jan. 5, 1944, Book 153, page 83, Deed Records, running thence South 13.48 chains to an interior corner in said tract; thence S. 82° W. 7.59 chains; thence S. 14° W. 3.36 chain; thence N. 87° W. 2 chains to the center of the main channel of Calapooia Creek; thence down the said main channel of Calapooia Creek to the East boundary line of the D.L.C. of Nicholas Springer, Not. No. 2439, Claim No. 53; thence North 2.50 chains to the South boundary line of the D.L.C. of Thomas S. Kendall, Not. No. 2313, Claim No. 45; thence S. 88½° E. 2.56 chains to the Southeast corner of said Kendall D.L.C.; thence N. 1° 27' W. on the dividing line between the said Kendall D.L.C. and the D.L.C. of James B. Roberts Not. No. 2436, Claim No. 51, 53.90 chains to the Northeast corner of said Thomas S. Kendall D.L.C.; thence North 2.72 chains, thence East 34.95 chains to the East boundary line of the Northwest quarter of said Section 29; thence S. 59.32 chains to the point of beginning and Subject to the rights of the public in roads.

If log of well is not available, give name and address of driller. Raymond Gattately, Philomath, Oregon

11. Infiltration Trench: Covered or open

Dimensions: Length ft. Minimum depth ft. Maximum depth ft.

Bottom width ft. Discharge g.p.m. Date of test

12. Tunnel; Type of lining

Dimensions:
(Length, course, and cross sectional size)

Position of water bearing stratum with reference to portal of tunnel.....

Log of tunnel: (Preceding table for log of well may be used, if desired. Give footage from portal and character of materials, as pertinent.)

13. Pumping Equipment:

(a) Pump Berkley 6" Turbine Capacity 400 g.p.m.
(Make, type and size)


(b) Motor 10 H. P. electric
(Type and horsepower)

14. Location of area irrigated or to be irrigated, or place of use if for purposes other than irrigation.

Township North or South	Range E. or W. of Willamette Meridian	Section	Forty-acre Tract	Number Acres To Be Irrigated	Date of Reclamation
12 S	3 W	29	SE $\frac{1}{4}$ of SW $\frac{1}{4}$	18.6	May, 1953
12 S	3 W	32	NE $\frac{1}{4}$ of NW $\frac{1}{4}$	12.4	May, 1953
				31.0	

15. If the ground water supply is supplemental to an existing water supply, identification of any application for a permit, permit, certificate or adjudicated right to appropriate water made or held by the registrant.

Township 12 S Range 3 W W.M.
North

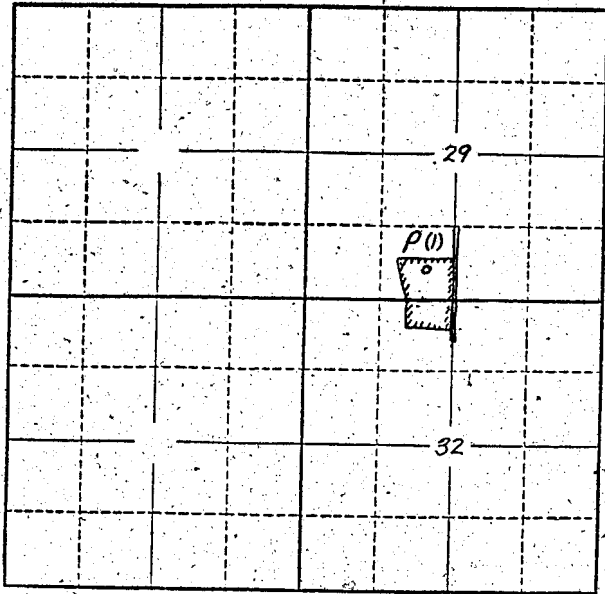

Locate well and acreage of irrigated land on plat.
Scale: 2" = 1 Mile

STATE OF OREGON

County of Linn } ss.

I, R. L. and Rosa Wirth, being first duly sworn, do hereby certify that I have read the foregoing Registration Statement and that all of the items therein contained are true to the best of my knowledge and belief.

R. L. Wirth
Rosa Wirth
(Signature of Registrant)

Subscribed and sworn to before me this 23rd day of July, 1957

My commission expires April 21, 1961

Frank Harding
(Notary Public)

(SEAL)

CERTIFICATE OF REGISTRATION

STATE OF OREGON

County of Marion } ss.

This is to certify that the foregoing Registration Statement was received in the office of the State Engineer on the 29th day of July, 1957 at 8:00 o'clock A. M. and has been duly recorded in said office in Book No. 3 of Registration Statements on page GR-531 C.

Witness my hand this 13th day of September, 1957

Lewis A. Starker
(State Engineer)

By _____ (Deputy)

15-15