REGISTRATION NO. GR 565
533

Registration Statement

OF CLAIMANT OF RIGHT TO APPROPRIATE GROUND WATER

(Under Chapter 708, Oregon Laws 1955.)

TO THE STATE ENGINEER OF OREGON:

I, John A. Johnson and Richard M. Armstrong,

of Route 1, Box 678, Warren, County of Columbia

State of Oregon, do hereby make application for a certificate of registration as evidence of a right to appropriate ground water.

1. **Source** from which water is withdrawn is Pump well (Flowing well, pump well, infiltration trench, or tunnel)

2. **Location** is: ½ mile South and 1½ miles West of Warren (Approximate distance and direction from nearest city or town);

and is more particularly described as follows:

(a) North 89°55' West 299.0 feet from Southeast corner of Northwest ¼ of Southwest ¼ (Give distance and bearing to corner of section or other legal subdivision)

being within Northwest ¼ of Southwest ¼ (Smallest legal subdivision) of Sec. 24, Twp. 4 North (N. or S.), Rge. 2 West (E. or W.)

or (b) within limits of recorded platted property, town or city:

in Lot ....., Block ..... of ..... (Name of plat or addition)

..... (If within city or town, give name) County of .....

3. **Construction Work** was begun on June 1950 (Date); was completed on June 1950 (Date)

and the ground water claimed was first used for the purposes set out below on June 1950 (Date),

since which time the water has been used Continuously (Continuously or intermittently)

from 1950 (Date) to Present (Date)

4. **Quantity** of water claimed and used is 150 gallons per minute; 0.33 acre feet per year.

5. **Purpose or Purposes** for which water is used irrigation

..... (Domestic, irrigation, municipal, manufacturing, industrial, etc.)

6. **Description of Well:** Depth 136 feet. Type drilled (Dug or drilled)

diameter 8" inches. Elevation of ground at well site 150 (As near as known) feet, mean sea level.

Depth to water table 86 feet.

7. **Capacity of Well:** 150 g.p.m. with 0 feet drawdown. (None recorded)

..... g.p.m. with ..... feet drawdown. Pumped for several hours and no appreciable change or drawdown

Date of test June 1950

If Flowing Well: Measured discharge ..... g.p.m. on ..... (Date)

Shut-in pressure at ground surface ..... lbs. per sq. in. on ..... (Date)

Water is controlled by ..... (Cap, valve, etc.)

8. **Casing:** (Give diameter, commercial specifications and depth below ground surface of each casing size.)

8 inch diameter from 0 to 136 feet

..... inch diameter from ..... to ..... feet

..... inch diameter from ..... to ..... feet

..... inch diameter from ..... to ..... feet

Describe and show depth of shoe, plug, adapter, liner or other details: .....

9. **Perforated Casings or Screens:**

No Record from ..... to .....
(Number per foot and size of perforations, or describe screen)

..... from ..... to .....

..... from ..... to .....

..... from ..... to .....

10. **Log of Well:** (Describe each stratum or formation clearly, indicate if water bearing, and give thickness and depth as indicated.)

MATERIAL	Thickness (Feet)	Depth to Bottom (Feet)
No Record - No Solid Rock - still bringing up sand		

GR-533-A

If log of well is not available, give name and address of driller. Scott Chapman
Pacific Drilling, Ordsmouse Oreg

11. **Infiltration Trench:** Covered or open .....

Dimensions: Length ..... ft. Minimum depth ..... ft. Maximum depth ..... ft.

Bottom width ..... ft. Discharge ..... g.p.m. Date of test .....

12. **Tunnel:** Type of lining .....

Dimensions: .....
(Length, course, and cross sectional size)

Position of water bearing stratum with reference to portal of tunnel .....

Log of tunnel: (Preceding table for log of well may be used, if desired. Give footage from portal and character of materials, as pertinent.)

13. **Pumping Equipment:**

(a) Pump Fairbanks Morse Turbine (Make, type and size) Capacity 150 g.p.m.

(b) Motor 15 horse power, 3ph. 440 volts (Type and horsepower)

14. Location of area irrigated or to be irrigated, or place of use if for purposes other than irrigation.

Township North or South	Range E. or W. of Willamette Meridian	Section	Forty-acre Tract	Number Acres To Be Irrigated	Date of Reclamation
4 North	2 West	24	S. W. ¼ of S. W. ¼	21.6	June 1950
4 "	2 "	24	N. W. ¼ of S. W. ¼	31.7	" "
4 "	2 "	24	N. E. ¼ of S. W. ¼	10.0	" "
4 "	2 "	24	S. E. ¼ of S. W. ¼	22.4	" "
4 "	2 "	24	S. W. ¼ of S. E. ¼	6.9	" "
				92.6	

Total area irrigated is 92.6 acres to be irrigated at the rate of 25 acres per year rotating each year so that the entire area is covered at least every 5 years.

15. If the ground water supply is supplemental to an existing water supply, identification of any application for a permit, permit, certificate or adjudicated right to appropriate water made or held by the registrant.

.....

.....

GR-533-B

Township 4 N, Range 2 W, W.M.

North

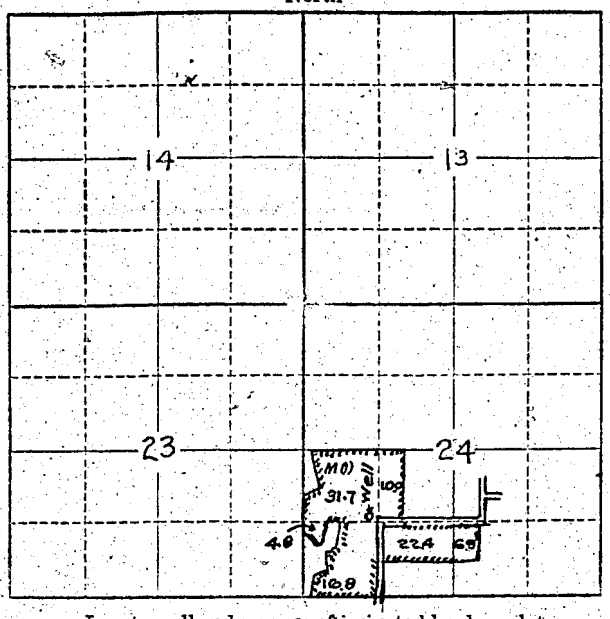

Locate well and acreage of irrigated land on plat.

Scale: 2" = 1 Mile

STATE OF OREGON }
County of COLUMBIA } ss.

I, John A. Johnson, being first duly sworn, do hereby certify that I have read the foregoing Registration Statement and that all of the items therein contained are true to the best of my knowledge and belief.

John A. Johnson
(Signature of Registrant)

Subscribed and sworn to before me this 27th day of June, 1957

My commission expires Sept. 30 1959

John L. Foote
(Notary Public)

(SEAL)

CERTIFICATE OF REGISTRATION

STATE OF OREGON }
County of Marion } ss.

This is to certify that the foregoing Registration Statement was received in the office of the State Engineer on the 29th day of July, 1957, at 8:00 o'clock A. M. and has been duly recorded in said office in Book No. 3 of Registration Statements on page GR-533 C

~~Construction should be completed by x x x x x x x x x x x x x x x and the water completely applied to beneficial use by x x x x x x x x x x x 19 x x~~

Witness my hand this 13th day of September, 1957

Lewis A. Stone
(State Engineer)

$24.45

By
(Deputy)

GR-533-C