

Registration Statement

OF CLAIMANT OF RIGHT TO APPROPRIATE GROUND WATER

TO THE STATE ENGINEER OF OREGON:

I, Hazel Malpass

of Rt. 1, Harrisburg County of Lane

(Mailing address)

State of OREGON, do hereby make application for a certificate of registration as evidence of a right to appropriate ground water.

1. Source from which water is withdrawn is Pump Well No. 1

(Flowing well, pump well, infiltration trench, or tunnel)

2. Location is: 6 miles south of Harrisburg, Oregon

(Approximate distance and direction from nearest city or town)

and is more particularly described as follows:

(a) S. 55° 18 E. 44.77 chains from the SW corner of John Ingram DIC 56, T. 16 S, R 14 W

(Give distance and bearing to corner of section or other legal subdivision)

being within SE 1/4 of NE 1/4 of Sec. 11, Twp. 16 S, Rge. 14 W

(Smallest legal subdivision)

(N. or S.)

(E. or W.)

or (b) within limits of recorded platted property, town or city:

in Lot _____, Block _____ of _____

(Name of plat or addition)

County of Lane

(If within city or town, give name)

3. Construction Work was begun on June 13, 1952; was completed on June 17, 1952

(Date)

(Date)

and the ground water claimed was first used for the purposes set out below on June 26, 1952

(Date)

since which time the water has been used continuously

(Continuously or intermittently)

from June 26, 1952 to present time

(Date)

(Date)

4. Quantity of water claimed and used is 375 4/10 gallons per minute; 87.0 acre

feet per year.

5. Purpose or Purposes for which water is used Irrigation

(Domestic, irrigation, municipal, manufacturing, industrial, etc.)

6. Description of Well: Depth 23 feet. Type Artesian (drum)

(Dug or drilled)

diameter 4 inches. Elevation of ground at well site 310 feet, mean sea level.

(As near as known)

Depth to water table 14 feet.

7. Capacity of Well: 455 g.p.m. with _____ feet drawdown.

_____ g.p.m. with _____ feet drawdown.

Date of test June 17, 1952

If Flowing Well: Measured discharge _____ g.p.m. on _____

(Date)


Shut-in pressure at ground surface _____ lbs. per sq. in. on _____

(Date)

Water is controlled by _____

(Cap, valve, etc.)

Township 16 S Range 1 W, W.M.
North

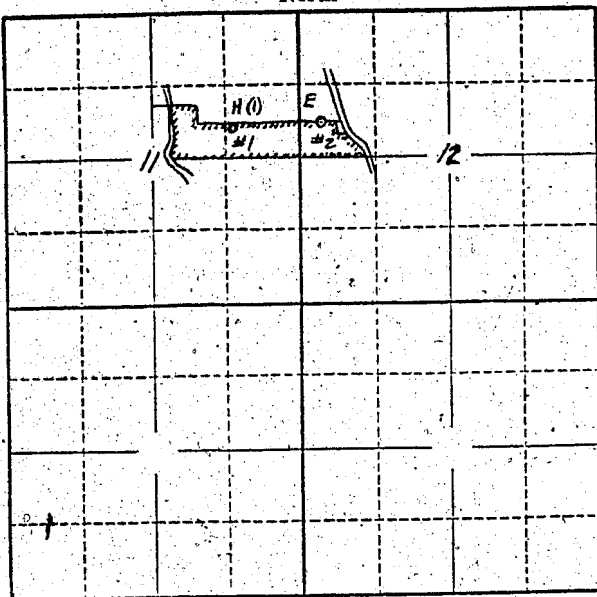

Locate well and acreage of irrigated land on plat.
Scale: 2" = 1 Mile

STATE OF OREGON } ss.
County of Linn

I, Hazel Malpass, being first duly sworn, do hereby certify that I have read the foregoing Registration Statement and that all of the items therein contained are true to the best of my knowledge and belief.

Hazel H. Malpass
(Signature of Registrant)

Subscribed and sworn to before me this 26th day of July, 1957.

My commission expires Oct 1, 1958
Emma D. Binns
(Notary Public)

(SEAL)

CERTIFICATE OF REGISTRATION

STATE OF OREGON } ss.
County of Marion

This is to certify that the foregoing Registration Statement was received in the office of the State Engineer on the 29th day of July, 1957, at 8:00 o'clock A. M. and has been duly recorded in said office in Book No. 3 of Registration Statements on page GR-534 C.

Witness my hand this 13th day of September, 1957.

#15.25

Lewis A. Stanley
(State Engineer)

By _____ (Deputy)