RECEIVED
JUL 1 1957
STATE ENGINEER
SALEM, OREGON

REGISTRATION NO. GR-562

Registration Statement

CERTIFICATE NO. 538

OF CLAIMANT OF RIGHT TO APPROPRIATE GROUND WATER

(Under Chapter 708, Oregon Laws 1955.)

TO THE STATE ENGINEER OF OREGON:

I, L. L. Bennett,

of Route 1, Box 27, Rogue River, County of Jackson

State of Oregon, do hereby make application for a certificate of registration as evidence of a right to appropriate ground water.

1. **Source** from which water is withdrawn is Infiltration trench
(Flowing well, pump well, infiltration trench, or tunnel)

2. **Location is:** 2 miles North of Rogue River, Oregon;
(Approximate distance and direction from nearest city or town)

and is more particularly described as follows:

(a) 265 feet South and 675 feet East from the corner Section 3
(Give distance and bearing to corner of section or other legal subdivision)

being within NW4 SW4 of Sec. 3, Twp. 36 (N. or S.), Rge. 4 (E. or W.)
(Smallest legal subdivision)

or (b) within limits of recorded platted property, town or city:

in Lot ....., Block ..... of .....
(Name of plat or addition)

..... County of .....
(If within city or town, give name)

3. **Construction Work** was begun on 1936 (Date); was completed on 1936 (Date)

and the ground water claimed was first used for the purposes set out below on 1936 (Date),

since which time the water has been used continuously
(Continuously or intermittently)

from 1936 (Date) to date (Date)

4. **Quantity** of water claimed and used is 150 gallons per minute; 76 acre feet per year.

5. **Purpose or Purposes** for which water is used Irrigation
(Domestic, irrigation, municipal, manufacturing, industrial, etc.)

See Item 6 6. **Description of Well:** Depth 24 feet. Type ..... (Dug or drilled)

diameter 50'x50' inches. Elevation of ground at well site 1100 (As near as known) feet, mean sea level.

Depth to water table 6 feet.

7. **Capacity of Well:** not known g.p.m. with ..... feet drawdown.

..... g.p.m. with ..... feet drawdown.

Date of test .....

If Flowing Well: Measured discharge ..... g.p.m. on ..... (Date)

Shut-in pressure at ground surface ..... lbs. per sq. in. on ..... (Date)

Water is controlled by .....
(Cap, valve, etc.)

8. **Casing:** (Give diameter, commercial specifications and depth below ground surface of each casing size.)

..... inch diameter ..... from ..... to ..... feet

..... inch diameter ..... from ..... to ..... feet

..... inch diameter ..... from ..... to ..... feet

..... inch diameter ..... from ..... to ..... feet

Describe and show depth of shoe, plug, adapter, liner or other details: .....

.....

.....

9. **Perforated Casings or Screens:**

..... from ..... to .....
(Number per foot and size of perforations, or describe screen)

..... from ..... to .....

..... from ..... to .....

..... from ..... to .....

10. **Log of Well:** (Describe each stratum or formation clearly, indicate if water bearing, and give thickness and depth as indicated.)

MATERIAL	Thickness (Feet)	Depth to Bottom (Feet)

GR-533 A

If log of well is not available, give name and address of driller. .....

11. **Infiltration Trench:** Covered or open open

Dimensions: Length 80 ft. Minimum depth 21 ft. Maximum depth 21 ft.

Bottom width 50 ft. Discharge 150 g.p.m. Date of test none

12. **Tunnel:** Type of lining .....

Dimensions: .....
(Length, course, and cross sectional size)

Position of water bearing stratum with reference to portal of tunnel .....

Log of tunnel: (Preceding table for log of well may be used, if desired. Give footage from portal and character of materials, as pertinent.)

13. **Pumping Equipment:**

(a) Pump 1.5 inch centrifugal pump (Make, type and size) Capacity 150 g.p.m.

(b) Motor 9.0 H.P. gasoline engine (Type and horsepower)

14. Location of area irrigated or to be irrigated, or place of use if for purposes other than irrigation.

Township North or South	Range E. or W. of Willamette Meridian	Section	Forty-acre Tract	Number Acres To Be Irrigated	Date of Reclamation
36 S.	4 W.	5	NW¼ SW¼	17 acres	1956

15. If the ground water supply is supplemental to an existing water supply, identification of any application for a permit, permit, certificate or adjudicated right to appropriate water made or held by the registrant.

none

GR-538 B

Township 34 S. Range 4 W., W.M.

North

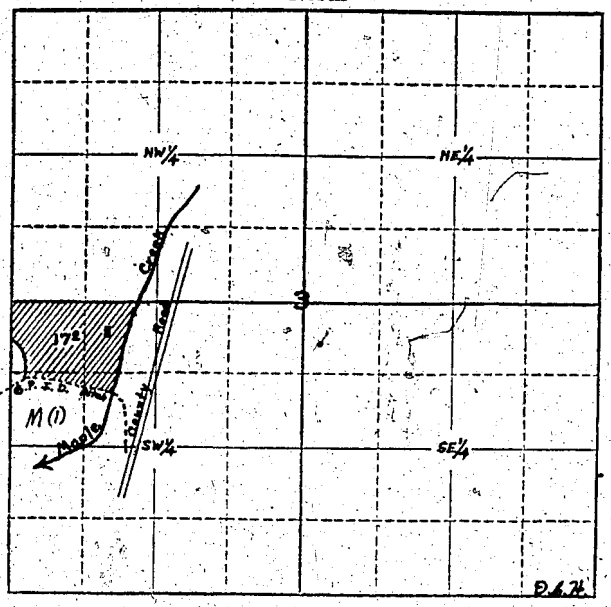

Locate well and acreage of irrigated land on plat.

Scale: 4" = 1 Mile

STATE OF OREGON
County of Jackson } ss.

I, L. L. Bennett, being first duly sworn, do hereby certify that I have read the foregoing Registration Statement and that all of the items therein contained are true to the best of my knowledge and belief.

X L L Bennett
(Signature of Registrant)

Subscribed and sworn to before me this 30th day of July, 1957

My commission expires Apr 3rd 1958 L. M. Stranger
(Notary Public)

(SEAL)

CERTIFICATE OF REGISTRATION

STATE OF OREGON
County of Marion } ss.

This is to certify that the foregoing Registration Statement was received in the office of the State Engineer on the 30th day of July, 1957, at 1:00 o'clock P. M. and has been duly recorded in said office in Book No. 3 of Registration Statements on page GR-538 C.

~~Construction shall be completed by _____ 19__, and the water completely applied to beneficial use by _____ 19__~~

Witness my hand this 13th day of September, 1957

Lewis A. Stanley
(State Engineer)

$15.00

By _____
(Deputy)

GR-538 C