

Registration Statement

OF CLAIMANT OF RIGHT TO APPROPRIATE GROUND WATER

TO THE STATE ENGINEER OF OREGON:

I, Philip G. Humphreys

of RFD 2, Box 403 H (Ross Lane) County of Jackson

State of Oregon, do hereby make application for a certificate of registration as evidence of a right to appropriate ground water.

1. Source from which water is withdrawn is Pump well
(Flowing well, pump well, infiltration trench, or tunnel)

2. Location is: approx. four miles West of Medford, Oregon
(Approximate distance and direction from nearest city or town)

and is more particularly described as follows:

(a) .152' west and 154' south of N.E. Corner of Lot 2, Block 1, Westwood Subd.
(Give distance and bearing to corner of section or other legal subdivision)
as filed with the Recorder of Jackson Co. June 3, 1950.
being within NW 1/4 of NE 1/4 of Sec. 21, Twp. 37S, Rge. 2W
(Smallest legal subdivision) (N. or S.) (E. or W.)

or (b) within limits of recorded platted property, town or city:

in Lot _____, Block _____ of _____
(Name of plat or addition)

County of _____
(If within city or town, give name)

3. Construction Work was begun on 4/23/53 (1st stage), was completed on 4/30/53
3/19/55 (2nd stage) 3/19/55
and the ground water claimed was first used for the purposes set out below on 4/30/53
(Date)

since which time the water has been used intermittently
(Continuously or intermittently)

from 4/30/53 to 6/13/57 (present date)
(Date) (Date)

4. Quantity of water claimed and used is 20 gallons per minute; 4.0 acre feet per year.

5. Purpose or Purposes for which water is used Irrigation of lawn and garden on lot
195' x 200', or .9 acre
(Domestic, irrigation, municipal, manufacturing, industrial, etc.)

6. Description of Well: Depth 42' feet. Type Dug and augered
(Dug or drilled)
diameter 36" to 10" inches. Elevation of ground at well site 100 feet, mean sea level.
24", 10' to 42'
(As near as known)
Depth to water table 8' feet.

7. Capacity of Well: 20 g.p.m. with 2' feet drawdown.
20 g.p.m. with 10' feet drawdown.

Date of test 4/30/53

If Flowing Well: Measured discharge _____ g.p.m. on _____
(Date)

Shut-in pressure at ground surface _____ lbs. per sq. in. on _____
(Date)

Water is controlled by _____
(Cap. valve, etc.)

8. Casing: (Give diameter, commercial specifications and depth below ground surface of each casing size.)

36" inch diameter concrete tile from 0' to 10' feet
 24" inch diameter Concrete tile from 10' to 26' feet
 inch diameter No casing from 26' to 42' feet
 inch diameter from to feet

Describe and show depth of shoe, plug, adapter, liner or other details: none

9. Perforated Casings or Screens:

None from to
(Number per foot and size of perforations, or describe screen)
 from to
 from to
 from to

10. Log of Well: (Describe each stratum or formation clearly, indicate if water bearing, and give thickness and depth as indicated.)

MATERIAL	Thickness (Feet)	Depth to Bottom (Feet)
Decomposed granite , water from 8' to 10'	10'	10'
Yellow clay, no water picked up	32'	42'

If log of well is not available, give name and address of driller. _____

11. Infiltration Trench: Covered or open none
Dimensions: Length ft. Minimum depth ft. Maximum depth ft.
Bottom width ft. Discharge g.p.m. Date of test

12. Tunnel: Type of lining none
Dimensions:
(Length, course, and cross sectional size)
Position of water bearing stratum with reference to portal of tunnel

Log of tunnel: (Preceding table for log of well may be used, if desired. Give footage from portal and character of materials, as pertinent.)

13. Pumping Equipment:
(a) Pump Pacific turbine, 1 1/2" Capacity 20 g.p.m.
(Make, type and size)
(b) Motor 1 HP General Electric, single phase, 220V, direct connected
(Type and horsepower)


14. Location of area irrigated or to be irrigated, or place of use if for purposes other than irrigation.

Township North or South	Range E. or W. of Willamette Meridian	Section	Forty-acre Tract	Number Acres To Be Irrigated	Date of Reclamation
37S	2W	21	Lot 2, Bl. 1, Westwood Subd., Jackson Co. Ore	.9	1953

15. If the ground water supply is supplemental to an existing water supply, identification of any application for a permit, permit, certificate or adjudicated right to appropriate water made or held by the registrant.
None

Township 37 S. Range 2 W., W.M.

North

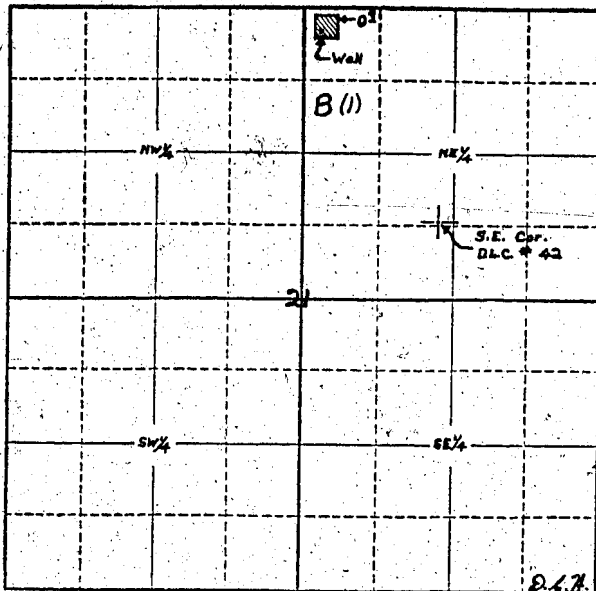

Locate well and acreage of irrigated land on plat.

Scale: 4" = 1 Mile

STATE OF OREGON

County of Jackson } ss.

I, R.G. Humphreys, being first duly sworn, do hereby certify that I have read the foregoing Registration Statement and that all of the items therein contained are true to the best of my knowledge and belief.

R.G. Humphreys
(Signature of Registrant)

Subscribed and sworn to before me this 1st day of August, 1957.

My commission expires March 20, 1959.

[Signature]
(Notary Public)

(SEAL)

CERTIFICATE OF REGISTRATION

STATE OF OREGON } ss.
County of Marion

This is to certify that the foregoing Registration Statement was received in the office of the State Engineer on the 2nd day of August, 1957, at 1:00 o'clock A. M. and has been duly recorded in said office in Book No. 3 of Registration Statements on page GR-541 C.

Witness my hand this 13th day of September, 1957.

\$ 15.00

Lewis A. Otterbein
(State Engineer)

By _____ (Deputy)

GR - 541 C