

Registration Statement

OF CLAIMANT OF RIGHT TO APPROPRIATE GROUND WATER

TO THE STATE ENGINEER OF OREGON:

I, Robert Sunamoto

of 12050 S. W. 135th Avenue, TIGARD, PORTLAND 23 County of Washington

(Mailing address)

State of Oregon, do hereby make application for a certificate of registration as evidence of a right to appropriate ground water.

1. Source from which water is withdrawn is Pump well
(Flowing well, pump well, infiltration trench, or tunnel)

2. Location is: 2 1/2 miles west of Tigard, Oregon
(Approximate distance and direction from nearest city or town)

(1070' So. & 2200' West from NE corner Sec 4) NW 1/4 of NE 1/4 of Sec 4 T 2 S R 1 W of W. M. Also that part of the SW 1/4 of the NE 1/4 of Sec 4 T 2 S R 1 W of W. M. lying immediate N & E of County Road No. 934 which traverses said SW 1/4 of the NE 1/4 of said Sec 4 T 2 S R 1 W of W. M. from (a) the NW corner to the SE corner thereof

(Give distance and bearing to corner of section or other legal subdivision)

being within 1/4 NW 1/4 NE 1/4 of Sec. 4, Twp. 2 S, Rge. 1 W
(Smallest legal subdivision) (N. or S.) (E. or W.)

or (b) within limits of recorded platted property, town or city: No

in Lot _____, Block _____ of _____
(Name of plat or addition)

No _____ County of Washington
(If within city or town, give name)

3. Construction Work was begun on 1953, was completed on 1953
(Date) (Date)

and the ground water claimed was first used for the purposes set out below on May 1954
(Date)

since which time the water has been used Every summer since
(Continuously or intermittently)

from May 1954 to present date July, 1957
(Date) (Date)

4. Quantity of water claimed and used is 250 gallons per minute; ? acre feet per year.

5. Purpose or Purposes for which water is used Irrigation

(Domestic, irrigation, municipal, manufacturing, industrial, etc.)

6. Description of Well: Depth 385 feet. Type drilled
(Dug or drilled)

diameter 8 inches. Elevation of ground at well site about 250 feet, mean sea level.
(As near as known)

Depth to water table 70 feet.

7. Capacity of Well: 250 g.p.m. with 120 feet drawdown.
_____ g.p.m. with _____ feet drawdown.

Date of test When drilled, 1953

If Flowing Well: Measured discharge No g.p.m. on _____
(Date)

Shut-in pressure at ground surface _____ lbs. per sq. in. on _____
(Date)

Water is controlled by _____
(Cap, valve, etc.)

8. Casing: (Give diameter, commercial specifications and depth below ground surface of each casing size.)

8 inch diameter top 350 feet cased, remainder in rock from to feet
..... inch diameter from to feet
..... inch diameter from to feet
..... inch diameter from to feet

Describe and show depth of shoe, plug, adapter, liner or other details:

9. Perforated Casings or Screens:

..... none perforated from to
(Number per foot and size of perforations, or describe screen)
..... from to
..... from to
..... from to

10. Log of Well: (Describe each stratum or formation clearly, indicate if water bearing, and give thickness and depth as indicated.)

MATERIAL	Thickness (Feet)	Depth to Bottom (Feet)
First 350 feet dirt last 35 feet rock		385

If log of well is not available, give name and address of driller.

Haakon I. Bottner, 1154 N. E. Glisan St., Portland, Oregon

11. Infiltration Trench: Covered or open none

Dimensions: Length _____ ft. Minimum depth _____ ft. Maximum depth _____ ft.

Bottom width _____ ft. Discharge _____ g.p.m. Date of test _____

12. Tunnel: Type of lining None

Dimensions: _____
(Length, course, and cross sectional size)

Position of water bearing stratum with reference to portal of tunnel _____

Log of tunnel: (Preceding table for log of well may be used, if desired. Give footage from portal and character of materials, as pertinent.)

13. Pumping Equipment:

(a) Pump Johnston 30HP Capacity 250 g.p.m.
(Make, type and size)

(b) Motor Electric 30 HP
(Type and horsepower)


14. Location of area irrigated or to be irrigated, or place of use if for purposes other than irrigation.

Township North or South	Range E. or W. of Willamette Meridian	Section	Forty-acre Tract	Number Acres To Be Irrigated	Date of Reclamation
2 South	1 West	4	SW 1/4	50	1953
2 S	1 W	4	NW 1/4 NE 1/4	40	1953
2 S	1 W	4	NE 1/4 & SW 1/4 NE 1/4	10	1953
2 S	1 W	4	NE PART of NW 1/4 of SW 1/4 NE 1/4	7	1953
				<u>57 Acres</u>	

15. If the ground water supply is supplemental to an existing water supply, identification of any application for a permit, permit, certificate or adjudicated right to appropriate water made or held by the registrant.

Section 4

Township 25 Range 17 W.M. North

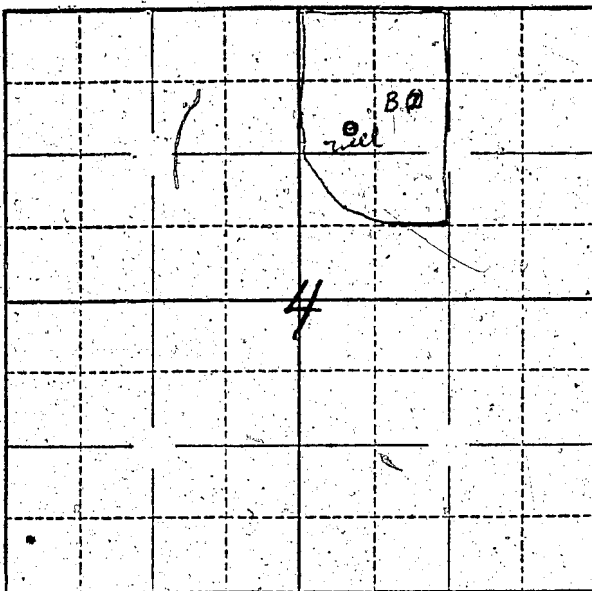

Locate well and acreage of irrigated land on plat.

Scale: 1/4" = 1 Mile

STATE OF OREGON

County of Washington

ss.

I, Robert Sunamoto, being first duly sworn, do hereby certify that I have read the foregoing Registration Statement and that all of the items therein contained are true to the best of my knowledge and belief.

Robert Sunamoto (Signature of Registrant)

Subscribed and sworn to before me this 25th day of July, 1957.

My commission expires August 18, 1960

W. Vincent (Notary Public for Oregon)

(SEAL)

CERTIFICATE OF REGISTRATION

STATE OF OREGON

County of Marion

ss.

This is to certify that the foregoing Registration Statement was received in the office of the State Engineer on the 5th day of August, 1957, at 8:00 o'clock A.M. and has been duly recorded in said office in Book No. 4 of Registration Statements on page GR-548 C.

Witness my hand this 13th day of September, 1957.

Lewis A. Stanley (State Engineer)

#1985

By (Deputy)

GR-548 C