

# Registration Statement

## OF CLAIMANT OF RIGHT TO APPROPRIATE GROUND WATER

TO THE STATE ENGINEER OF OREGON:

I, Max D. Mayfield

of Route # 1 Box 170, Independence, Ora. County of Polk  
(Mailing address)

State of Oregon, do hereby make application for a certificate of registration as evidence of a right to appropriate ground water.

1. Source from which water is withdrawn is Pump Well  
(Flowing well, pump well, infiltration trench, or tunnel)

2. Location is: Two Miles South of Independence, Oregon  
(Approximate distance and direction from nearest city or town)

and is more particularly described as follows:

(a) 200' N. and 500' E. from SW corner Sec 8  
(Give distance and bearing to corner of section or other legal subdivision)

being within S.W. 1/4, S.W. 1/4 of Sec. 8, Twp. 9 S. Rge. 4 W.  
(Smallest legal subdivision) (N. or S.) (E. or W.)

or (b) within limits of recorded platted property, town or city:

in Lot \_\_\_\_\_, Block \_\_\_\_\_ of \_\_\_\_\_  
(Name of plat or addition)

County of \_\_\_\_\_  
(If within city or town, give name)

3. Construction Work was begun on 1948; was completed on 1948  
(Date) (Date)

and the ground water claimed was first used for the purposes set out below on 1948  
(Date)

since which time the water has been used Continuously  
(Continuously or Intermittently)

from May to Sept.  
(Date) (Date)

4. Quantity of water claimed and used is 50 gallons per minute; 30 acre feet per year.

5. Purpose or Purposes for which water is used Irrigation  
(Domestic, irrigation, municipal, manufacturing, industrial, etc.)

6. Description of Well: Depth 120 feet. Type Drilled  
(Dug or drilled)

diameter 6 inches. Elevation of ground at well site 250 feet, mean sea level.  
(As near as known)

Depth to water table 10 feet.

7. Capacity of Well: 50 g.p.m. with 40 feet drawdown.

\_\_\_\_\_ g.p.m. with \_\_\_\_\_ feet drawdown.

Date of test \_\_\_\_\_

If Flowing Well: Measured discharge \_\_\_\_\_ g.p.m. on \_\_\_\_\_  
(Date)


Shut-in pressure at ground surface \_\_\_\_\_ lbs. per sq. in. on \_\_\_\_\_  
(Date)

Water is controlled by \_\_\_\_\_  
(Cap, valve, etc.)





Township 9 S Range 4 W W.M.  
North

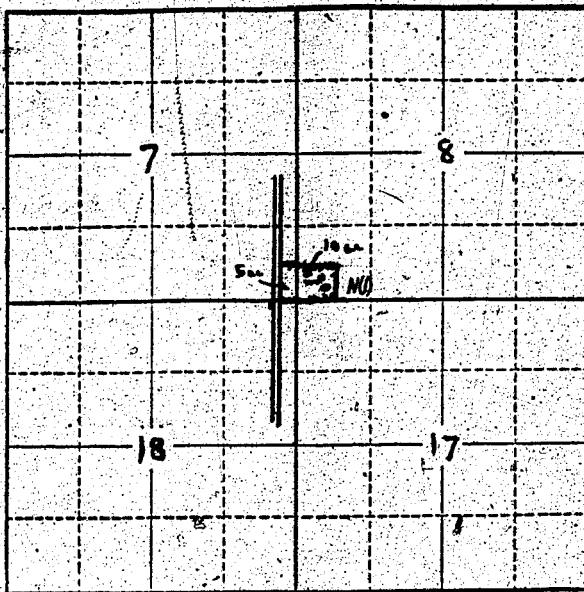

Locate well and acreage of irrigated land on plat.  
Scale: 2" = 1 Mile

STATE OF OREGON

County of Marion ss.

I, Max D. Mayfield, being first duly sworn, do hereby certify that I have read the foregoing Registration Statement and that all of the items therein contained are true to the best of my knowledge and belief.

Max D. Mayfield  
(Signature of Registrant)

Subscribed and sworn to before me this 5<sup>th</sup> day of August, 1957.

My commission expires Sept. 8, 1960

Clair T. Hill  
(Notary Public)

(SEAL)

### CERTIFICATE OF REGISTRATION

STATE OF OREGON

County of Marion ss.

This is to certify that the foregoing Registration Statement was received in the office of the State Engineer on the 5<sup>th</sup> day of August, 1957, at 10:00 o'clock A. M. and has been duly recorded in said office in Book No. 4 of Registration Statements on page GR-549 C.

Witness my hand this 13<sup>th</sup> day of September, 1957.

Lewis A. Stanley  
(State Engineer)

By \_\_\_\_\_

(Deputy)

GR - 549 C