REGISTRATION NO. GX 579

Registration Statement

CERTIFICATE NO. GR 551

OF CLAIMANT OF RIGHT TO APPROPRIATE GROUND WATER

(Under Chapter 708, Oregon Laws 1955.)

TO THE STATE ENGINEER OF OREGON:

I, Perrydale Orchard by Allan F. Perry

of 105 Geneva Avenue, Medford County of Jackson

State of Oregon, do hereby make application for a certificate of registration as evidence of a right to appropriate ground water.

1. **Source** from which water is withdrawn is #2 Infiltration Trench
(Flowing well, pump well, infiltration trench, or tunnel)

2. **Location** is: 2 Miles West of Medford, Oregon
(Approximate distance and direction from nearest city or town)

and is more particularly described as follows:

(a) 1306 feet south and 140 feet East from the NE corner DLC #74
(Give distance and bearing to corner of section or other legal subdivision)

being within NW¼ SW¼ of Sec. 26, Twp. 37 S. (N. or S.), Rge. 2 W. (E. or W.)
(Smallest legal subdivision)

or (b) within limits of recorded platted property, town or city:

in Lot ....., Block ..... of .....
(Name of plat or addition)

..... County of .....
(If within city or town, give name)

3. **Construction Work** was begun on April 19, 1955 (Date); was completed on May 18, 1955 (Date)

and the ground water claimed was first used for the purposes set out below on May 1955 (Date)

since which time the water has been used continuously
(Continuously or intermittently)

from May 1955 (Date) to date (Date).

4. **Quantity** of water claimed and used is 60 gallons per minute; 27 acre feet per year.

5. **Purpose or Purposes** for which water is used irrigation
(Domestic, irrigation, municipal, manufacturing, industrial, etc.)

See Item 11

6. **Description of Well:** Depth 18 feet. Type dug (Dug or drilled)

diameter 20'x125' ~~inches~~. Elevation of ground at well site 1400 (As near as known) feet, mean sea level.

Depth to water table 5.0 feet.

7. **Capacity of Well:** not knowng.p.m. with ..... feet drawdown.

..... g.p.m. with ..... feet drawdown.

Date of test none

If Flowing Well: Measured discharge ..... g.p.m. on ..... (Date)

Shut-in pressure at ground surface ..... lbs. per sq. in. on ..... (Date)

Water is controlled by .....
(Cap, valve, etc.)

8. **Casing:** (Give diameter, commercial specifications and depth below ground surface of each casing size.)

..... inch diameter ....none.... from ..... to ..... feet

..... inch diameter ..... from ..... to ..... feet

..... inch diameter ..... from ..... to ..... feet

..... inch diameter ..... from ..... to ..... feet

Describe and show depth of shoe, plug, adapter, liner or other details: .....

9. **Perforated Casings or Screens:**

....none.... from ..... to .....
(Number per foot and size of perforations, or describe screen)

..... from ..... to .....

..... from ..... to .....

..... from ..... to .....

10. **Log of Well:** (Describe each stratum or formation clearly, indicate if water bearing, and give thickness and depth as indicated.)

MATERIAL	Thickness (Feet)	Depth to Bottom (Feet)
Sandy loam	8	10
Gravel	2	8
Clay	7	1
Gravel	1	--

GR- 551 A

If log of well is not available, give name and address of driller. .....

11. **Infiltration Trench:** Covered or open .....open

Dimensions: Length .....125 ft. Minimum depth .....12 ft. Maximum depth .....18 ft.

Bottom width .....20 ft. Discharge .....60 g.p.m. Date of test .....none

12. **Tunnel:** Type of lining .....

Dimensions: .....
(Length, course, and cross sectional size)

Position of water bearing stratum with reference to portal of tunnel .....

Log of tunnel: (Preceding table for log of well may be used, if desired. Give footage from portal and character of materials, as pertinent.)

13. **Pumping Equipment:**

(a) Pump .....Gould 2" centrifugal pump..... Capacity .....60 g.p.m.
(Make, type and size)

(b) Motor .....6 H.P. Briggs Stratton gasoline engine.....
(Type and horsepower)

14. Location of area irrigated or to be irrigated, or place of use if for purposes other than irrigation.

Township North or South	Range E. or W. of Willamette Meridian	Section	Forty-acre Tract	Number Acres To Be Irrigated	Date of Reclamation
37 S.	2 W.	26	NW¼ SW¼	6.0 acres	May - 1955

15. If the ground water supply is supplemental to an existing water supply, identification of any application for a permit, permit, certificate or adjudicated right to appropriate water made or held by the registrant.

none

Township 37 S Range 2 W, W.M.

North

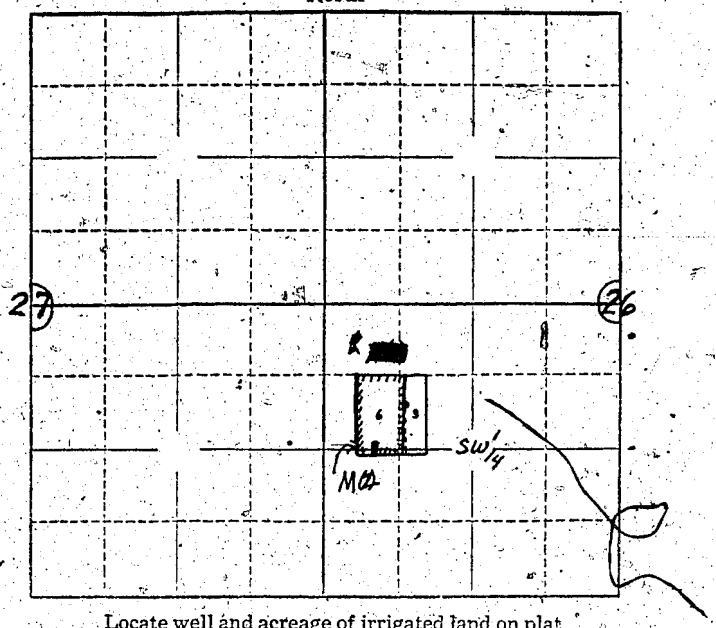

Locate well and acreage of irrigated land on plat.

Scale: 4" = 1 Mile

STATE OF OREGON
County of Jackson } ss.

I, Allan F. Berry, being first duly sworn, do hereby certify that I have read the foregoing Registration Statement and that all of the items therein contained are true to the best of my knowledge and belief.

Jerrydale Orchard
Allan F. Berry
(Signature of Registrant)

Subscribed and sworn to before me this 31st day of July, 1957

My commission expires May 21, 1958 Robert Cunningham
(Notary Public)

(SEAL)

CERTIFICATE OF REGISTRATION

STATE OF OREGON
County of Marion } ss.

This is to certify that the foregoing Registration Statement was received in the office of the State Engineer on the 8th day of August, 1957, at 1:00 o'clock P. M. and has been duly recorded in said office in Book No. 4 of Registration Statements on page GR-551

~~Certificate shall be recorded on the water right applied for beginning on page~~

Witness my hand this 13th day of September, 1957

Lewis A. Stanley
(State Engineer)

$15.00

By
(Deputy)

GR-551 C