

Registration Statement

REGISTRATION NO. GR-580
CERTIFICATE NO. GR-552

OF CLAIMANT OF RIGHT TO APPROPRIATE GROUND WATER

(Under Chapter 708, Oregon Laws 1955.)

TO THE STATE ENGINEER OF OREGON:

I, G. W. HARRA

of 745 STEWART ST., SALEM County of MARION

State of OREGON, do hereby make application for a certificate of registration as evidence of a right to appropriate ground water.

1. Source from which water is withdrawn is PUMP WELL
(Flowing well, pump well, infiltration trench, or tunnel)

2. Location is: 5 MI. S. OF SALEM CRE
(Approximate distance and direction from nearest city or town)

and is more particularly described as follows:

(a) N. 73° 10' E. 1040 FT. FROM W 1/4 COR. SEC. 15, T. 8 S. R. 3 W
(Give distance and bearing from corner of section or other legal subdivision)

being within W 1/4 NW 1/4 of Sec. 15, Twp. 8 S, Rge. 3 W
(Smallest legal subdivision) (N. or S) (E. or W.)

or (b) within limits of recorded platted property, town or city:

in Lots 89 & 90, Block _____ of SEANESIDE FRUIT FARMS No. 3
(Name of plat or addition)

County of MARION
(If within city or town, give name)

3. Construction Work was begun on OCT. 1951; was completed on OCT. 1951
(Date) (Date)

and the ground water claimed was first used for the purposes set out below on MAY 1952
(Date)

since which time the water has been used INTERMITTENTLY
(Continuously or intermittently)

from MAY 1952 to SEPT. 1952
(Date) (Date)

4. Quantity of water claimed and used is 250 gallons per minute; _____ acre feet per year.

5. Purpose or Purposes for which water is used IRRIGATION

USE FOR MUNICIPAL
(Domestic, irrigation, municipal, manufacturing, industrial, etc.)

6. Description of Well: Depth 67 feet. Type DRILLED

diameter 12 inches. Elevation of ground at well site 420 feet, mean sea level.
(As near as known)

Depth to water table 1 1/2 feet.

7. Capacity of Well: 175 g.p.m. with 1 1/2 feet drawdown.

_____ g.p.m. with _____ feet drawdown.

Date of test OCT. 1951

If Flowing Well: Measured discharge _____ g.p.m. on _____
(Date)

Shut-in pressure at ground surface _____ lbs. per sq. in. on _____
(Date)

Water is controlled by _____
(Cap, valve, etc.)

8. Casing: (Give diameter, commercial specifications and depth below ground surface of each casing size.)

8 inch diameter STEEL CASING (33' PERFORATED) from 0 to 67 feet
 inch diameter from to feet
 inch diameter from to feet
 inch diameter from to feet

Describe and show depth of shoe, plug, adapter, liner or other details:

9. Perforated Casings or Screens:

N.T. KNOWN from 34 to 67
 (Number per foot and size of perforations, or describe screen)
 from to
 from to
 from to

10. Log of Well: (Describe each stratum or formation clearly, indicate if water bearing, and give thickness and depth as indicated.)

MATERIAL	Thickness (Feet)	Depth to Bottom (Feet)
RED CLAY AND SILT	12	12
BLUE CLAY	9	21
LOOSE FORMATION OF DISINTEGRATED BASALT, SANDSTONE, AND CONGLOMERATE	45	66
SOLID BASALT	1	67

If log of well is not available, give name and address of driller. *Duffield Bros.*

11. Infiltration Trench: Covered or open

Dimensions: Length ft. Minimum depth ft. Maximum depth ft.
 Bottom width ft. Discharge g.p.m. Date of test

12. Tunnel: Type of lining

Dimensions:
(Length, course, and cross sectional size)
 Position of water bearing stratum with reference to portal of tunnel

Log of tunnel: (Preceding table for log of well may be used, if desired. Give footage from portal and character of materials, as pertinent.)

13. Pumping Equipment:


(a) Pump *Centrifugal* Capacity g.p.m.
(Make, type and size)
 (b) Motor *10 HP ?*
(Type and horsepower)

14. Location of area irrigated or to be irrigated, or place of use if for purposes other than irrigation.

Township North or South	Range E. or W. of Willamette Meridian	Section	Forty-acre Tract	Number Acres To Be Irrigated	Date of Reclamation
<i>75</i>	<i>3W</i>	<i>15</i>	<i>SW 1/4 NW 1/4</i>	<i>18</i>	<i>May 1952</i>
<i>85</i>	<i>3W</i>	<i>15</i>	<i>SE 1/4 - NW 1/4</i>	<i>10</i>	<i>" "</i>

15. If the ground water supply is supplemental to an existing water supply, identification of any application for a permit, permit, certificate or adjudicated right to appropriate water made or held by the registrant.

Township 7 S Range 3 W W.M.
North

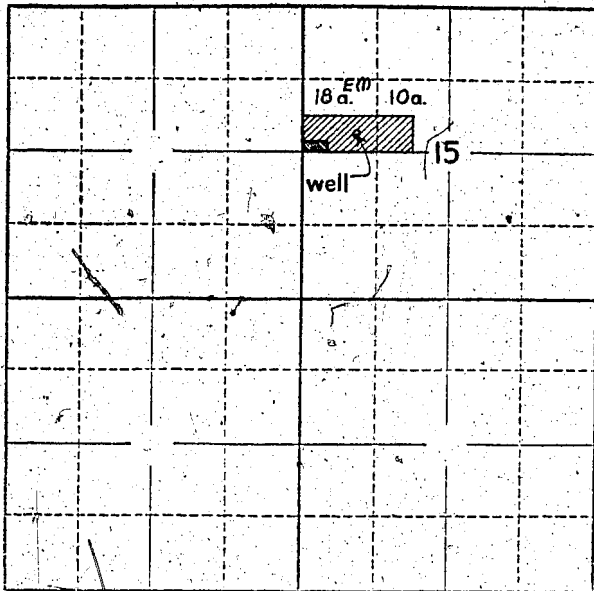

Locate well and acreage of irrigated land on plat.
Scale: 2" = 1 Mile

STATE OF OREGON

County of _____

ss.

I, D.W. Haura, being first duly sworn, do hereby certify that I have read the foregoing Registration Statement and that all of the items therein contained are true to the best of my knowledge and belief.

D.W. Haura
(Signature of Registrant)

Subscribed and sworn to before me this 8th day of August, 1957

My commission expires June 12th, 1961

Wm. S. Bartholmey
(Notary Public)

(SEAL)

CERTIFICATE OF REGISTRATION

STATE OF OREGON

County of Marion

ss.

This is to certify that the foregoing Registration Statement was received in the office of the State Engineer on the 8th day of August, 1957, at 11:30 o'clock A. M. and has been duly recorded in said office in Book No. 4 of Registration Statements on page GR-552 C.

~~xy Construction shall be completed by x-x-x-x-x-x-x-x-x-x-10-x-x and the water completely applied to beneficial uses by x-x-x-x-x-x-x-x-x-x-14-x-x xy~~

Witness my hand this 13th day of September, 1957.

Laura A. Steen
(State Engineer)

By _____

(Deputy)

GR-552 C