

Registration No. GR-583

Certificate No. GR-555

# Registration Statement

## OF CLAIMANT OF RIGHT TO APPROPRIATE GROUND WATER

TO THE STATE ENGINEER OF OREGON:

I, Kyle and Mary Folsom  
 of Rt. 1, Box 268 M, Albany County of Linn  
(Mailing address)  
 State of Oregon, do hereby make application for a certificate of registration as evidence  
 of a right to appropriate ground water.

1. Source from which water is withdrawn is Pump Well No. 1  
(Flowing well, pump well, infiltration trench, or tunnel)

2. Location is: 7 1/2 miles East of Albany, Oregon  
(Approximate distance and direction from nearest city or town)

and is more particularly described as follows:

(a) S. 69° 40' W. 45 chains from the NE corner DLG 40, T. 11 S., R. 2 W.  
(Give distance and bearing to corner of section or other legal subdivision)  
 being within NE 1/4 of NW 1/4 of Sec. 5, Twp. 11 S., Rge. 2 W.  
(Smallest legal subdivision) (N. or S.) (E. or W.)

or (b) within limits of recorded platted property, town or city:

in Lot \_\_\_\_\_, Block \_\_\_\_\_ of \_\_\_\_\_  
(Name of plat or addition)  
 \_\_\_\_\_ County of Linn  
(If within city or town, give name)

3. Construction Work was begun on Nov. 1, 1946; was completed on Nov. 2, 1946  
(Date) (Date)

and the ground water claimed was first used for the purposes set out below on May 10, 1947  
(Date)

since which time the water has been used continuously  
(Continuously or intermittently)

from May 10, 1947 to present time  
(Date) (Date)

4. Quantity of water claimed and used is 700 gallons per minute; 152.25 acre  
 feet per year.

5. Purpose or Purposes for which water is used Irrigation

(Domestic, irrigation, municipal, manufacturing, industrial, etc.)

6. Description of Well: Depth 20 1/2 feet. Type Drilled  
(Dug or drilled)

diameter 10 inches. Elevation of ground at well site 250 feet, mean sea level.  
(As near as known)

Depth to water table 8 feet.

7. Capacity of Well: 1000 g.p.m. with 1 1/2 feet drawdown.

\_\_\_\_\_ g.p.m. with \_\_\_\_\_ feet drawdown.

Date of test Sept. 1, 1952

If Flowing Well: Measured discharge \_\_\_\_\_ g.p.m. on \_\_\_\_\_  
(Date)

Shut-in pressure at ground surface \_\_\_\_\_ lbs. per sq. in. on \_\_\_\_\_  
(Date)

Water is controlled by \_\_\_\_\_  
(Cap, valve, etc.)

8. Casing: (Give diameter, commercial specifications and depth below ground surface of each casing size.)

10 inch diameter steel casing from 0 to 20<sup>1</sup> feet  
 inch diameter from to feet  
 inch diameter from to feet  
 inch diameter from to feet

Describe and show depth of shoe, plug, adapter, liner or other details:

9. Perforated Casings or Screens:

slot perforations from 8<sup>1</sup>/<sub>2</sub> to 20<sup>1</sup>  
(Number per foot and size of perforations, or describe screen)  
 from to  
 from to  
 from to

10. Log of Well: (Describe each stratum or formation clearly, indicate if water bearing, and give thickness and depth as indicated.)

MATERIAL	Thickness (Feet)	Depth to Bottom (Feet)
Not available		

Deeds Vol. 230 Page 263 Kyle B. Folsom et ux to F. I. Folsom et ux

An easement for a water pipe line leading from the well situated near the western boundary of the South projection of the hereinafter described premises southeasterly to the County road at a point approximately 100 ft. westerly from the S. E. corner of the hereinafter described premises, together with the right to go upon the premises to maintain said pipe line and to install and maintain a pump at said well and to install and maintain an electrical power transmission line to said pump along and adjacent to the western boundary line of said premises which said easement shall be perpetual, the grantees to be liable for any damage to crops occasioned through maintenance of said line, the said easement to be over and across the following described premises, to-wit:

Beginning at a point which is north 71° 15' W. 23.58 chains from the N. E. corner of the D. L. C. of John A. Powell, Not. No. 1197, Claim No. 40 in T. 10 and 11 S., R. 2 W., W. M. thence N. 71° 15' W. 4.57 chains; thence S. 19° 30' W. 21.88 chains; thence N. 68° W. 7.40 chains to the center of a county road; thence S. along the center of said county road 17.80 chains; more or less, to a point where the center of said county road intersects the center of a county road running easterly and westerly; thence easterly along the center of said county road to the S. W. corner of a tract of land heretofore deeded to W. E. Cade and Alta Cade by deed recorded Deed Records Book 142, page 176; thence northeasterly along the W. boundary line of the said W. E. Cade and Alta Cade tract of land to the place of beginning, all lying and being situated in Linn County, state of Oregon.

If log of well is not available, give name and address of driller. Slate Drilling Co., Tangent, Oregon.

11. Infiltration Trench: Covered or open .....

Dimensions: Length ..... ft. Minimum depth ..... ft. Maximum depth ..... ft.

Bottom width ..... ft. Discharge ..... g.p.m. Date of test .....

12. Tunnel: Type of lining .....

Dimensions: .....  
(Length, course, and cross sectional size)

Position of water bearing stratum with reference to portal of tunnel .....

Log of tunnel: (Preceding table for log of well may be used, if desired. Give footage from portal and character of materials, as pertinent.)

13. Pumping Equipment:

Allis Chalmers 2 1/2" centrifugal  
 (a) Pump Cornell Rainflow 2 1/2" centrifugal Capacity 300  
 10 H. P. electric (Make, type and size) 420 g.p.m.  
 (b) Motor 15 H. P. electric  
 (Type and horsepower)


14. Location of area irrigated or to be irrigated, or place of use if for purposes other than irrigation.

Township North or South	RANGE E. or W. of Willamette Meridian	Section	Forty-acre Tract	Number Acres To Be Irrigated	Date of Reclamation
11 S	2 W	5	NE 1/4 of NW 1/4	6.0	May 10, 1947
11 S	2 W	5	SE 1/4 of NW 1/4	7.5	" "
11 S	2 W	5	SW 1/4 of NW 1/4	0.1	" "
11 S	2 W	5	NW 1/4 of NW 1/4 NE 1/4	1.7	" "
11 S	2 W	5	SW 1/4 of NE 1/4	9.5	" "
11 S	2 W	5	SE 1/4 of NW 1/4	15.6	" "
11 S	2 W	5	NE 1/4 of SW 1/4	15.2	" "
11 S	2 W	5	NW 1/4 of SW 1/4	0.1	" "
11 S	2 W	5	NW 1/4 of SE 1/4	5.2	" "
				60.9	

Beginning at the NE corner of DLC of John A. Fowell, Not. No. 1197, Claim No. 40, said claim being situated in T. 11 S. of R. 4 W. of W.M. in Linn County, Oregon, and running thence Northwesterly along the Northern boundary line of said DLC a distance of 35.55 chains; thence S. 19° 30' West 39.68 chains to the center of a county road for a place of beginning; thence S. 19° 30' West along the center of a county road to the NW corner of a tract of land heretofore conveyed to Clara E. and W. VanHorn on the 18th day of January, 1928, recorded at page 275, Volume 133 of the Deed Records of Linn County, Oregon; thence S. 81° 30' E. 23.68 chains to the ONE corner of said tract of land conveyed to Clara E. and W. VanHorn aforesaid; thence northerly 19° 30' East 25.69 chains to the center of a county road; thence Westerly along the center of said county road to the place of beginning, save and excepting therefrom a three and one-third-acre tract of land lying situated in the NW corner of the above described tract, which said three and one-third-acre tract is described as follows:

Beginning at the NW corner of the tract of land herein first described and running thence Easterly along the Northern boundary line of said tract a distance of 9 chains; thence southwesterly and parallel with the Western boundary line of said tract a distance of 5 chains; thence northwesterly to the Western boundary line of said tract at a point 2 5/8 chains S. of the place of beginning; thence northerly to the place of beginning.

Township 11 S Range 2 W., W.M.  
North

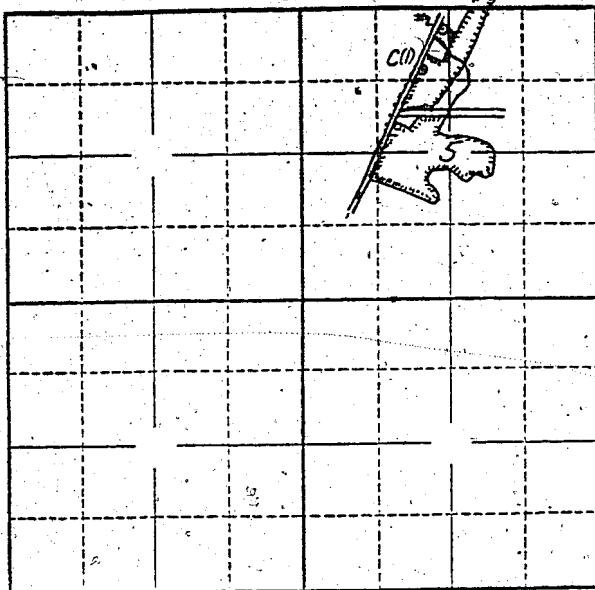

Locate well and acreage of irrigated land on plat.  
Scale: 2" = 1 Mile

STATE OF OREGON

County of Linn } ss.

I, Kyle and Mary Folsom, being first duly sworn, do hereby certify that I have read the foregoing Registration Statement and that all of the items therein contained are true to the best of my knowledge and belief.

Kyle B Folsom  
Mary Folsom  
(Signature of Registrant)

Subscribed and sworn to before me this 14<sup>th</sup> day of June, 1957.

My commission expires May 31 1958 Lela Nelson  
(Notary Public)

(SEAL)

**CERTIFICATE OF REGISTRATION**

STATE OF OREGON

County of Marion } ss.

This is to certify that the foregoing Registration Statement was received in the office of the State Engineer on the 13th day of August, 1957, at 8:00 o'clock A. M. and has been duly recorded in said office in Book No. 4 of Registration Statements, page GR-555 C.

Witness my hand this 13th day of September, 1957.

Lewis A. Stanley  
(State Engineer)

By \_\_\_\_\_  
(Deputy)