

Registration Statement

OF CLAIMANT OF RIGHT TO APPROPRIATE GROUND WATER

TO THE STATE ENGINEER OF OREGON:

I, ELVA L. WEST

of Route 2, Forest Grove

(Mailing address)

County of Washington

State of Oregon, do hereby make application for a certificate of registration as evidence of a right to appropriate ground water.

1. Source from which water is withdrawn is pump well #1
(Flowing well, pump well, infiltration trench, or tunnel)

2. Location is: 1 1/2 miles Southeast of Forest Grove, Oregon
(Approximate distance and direction from nearest city or town)

and is more particularly described as follows:

(a) The description of Fruitvale Addition is attached hereto.

(Give distance and bearing to corner of section or other legal subdivision)

being within Southeast one-fourth of Sec. 1 N. 2 E. 1 S. Twp. 1 S. Rge. 3 W.
(Smallest legal subdivision) (N. or S.) (E. or W.)

or (b) within limits of recorded platted property, town or city:
Lot 8, 9, part Lot 10, part of lot 1. all of lot 11
in Lot , Block of and part of Lot 10, Fruitvale Addition to
(Name of plat or addition)

Forest Grove County of Washington
(If within city or town, give name)

3. Construction Work was begun on 1944; was completed on 1945
(Date) (Date)

and the ground water claimed was first used for the purposes set out below on 1945
(Date)

since which time the water has been used continuously
(Continuously or Intermittently)

from 1945 to present time
(Date) (Date)

4. Quantity of water claimed and used is 50 gallons per hour minute acre
feet per year. Amount of water claimed and used is that flowing from a one
inch pipe to service four Rainbird sprinklers

5. Purpose or Purposes for which water is used watering cattle and irrigation

(Domestic, irrigation, municipal, manufacturing, industrial, etc.)

6. Description of Well: Depth 100 feet. Type drilled
(Dug or drilled)

diameter 6 inches. Elevation of ground at well site 90 feet, mean sea level:
(As near as known)

Depth to water table 35 feet.

7. Capacity of Well: g.p.m. with feet drawdown.

 g.p.m. with feet drawdown.

Date of test

If Flowing Well: Measured discharge g.p.m. on (Date)

Shut-in pressure at ground surface lbs. per sq. in. on (Date)

Water is controlled by
(Cap, valve, etc.)

If log of well is not available, give name and address of driller. Frank Blair, formerly of Watts District near Forest Grove, but present address unknown

11. Infiltration Trench: Covered or open

Dimensions: Length ft. Minimum depth ft. Maximum depth ft.

Bottom width ft. Discharge g.p.m. Date of test

12. Tunnel: Type of lining

Dimensions:
(Length, course, and cross sectional size)

Position of water bearing stratum with reference to portal of tunnel

Log of tunnel: (Preceding table for log of well may be used, if desired. Give footage from portal and character of materials, as pertinent.)

13. Pumping Equipment:

(a) Pump Fairbanks-Morse Pomona Turbine Capacity 50 g.p.m.
(Make, type and size)

(b) Motor 3 H.P. Electric
(Type and horsepower)

14. Location of area irrigated or to be irrigated, or place of use if for purposes other than irrigation.


Township North or South	Range E. or W. of Willamette Meridian	Section	Forty-acre Tract	Number Acres To Be Irrigated	Date of Reclamation
Irrigate about 6 acres of pasture land, and water stock, all in Lots 8 and Lot 11, Fruitvale Addition to the City of Forest Grove, Oregon, and approximately one-half acre in Lot 9, Fruitvale Addition to the City of Forest Grove, Oregon					
T1S	R3W	5	SE 1/4 of NW 1/4	6.0 Ac	1945
"	"	5	SW 1/4 of NE 1/4	.5 Ac	
				6.5 Ac	

The following is a description of the Fruitvale Addition to the City of Forest Grove, Washington County, Oregon.

Beginning at a point on the Base Line 10.30 chains East of the quarter post between sections 32 T1N, R3W and Section 5, T1S, R3W; thence South 0° and 11' West 34.40 chains; thence North 89° 55' West 30.85 chains; thence North 0° 57' to a stone corner; thence North 0° 11' West about 14.50 chains to the Base Line; thence East to the place of beginning, being a part of Section 5 and of the E.M. Catching S.I.C.

15. If the ground water supply is supplemental to an existing water supply, identification of any application for a permit, permit, certificate or adjudicated right to appropriate water made or held by the registrant.

Township 1S Range 3W, W.M.
North

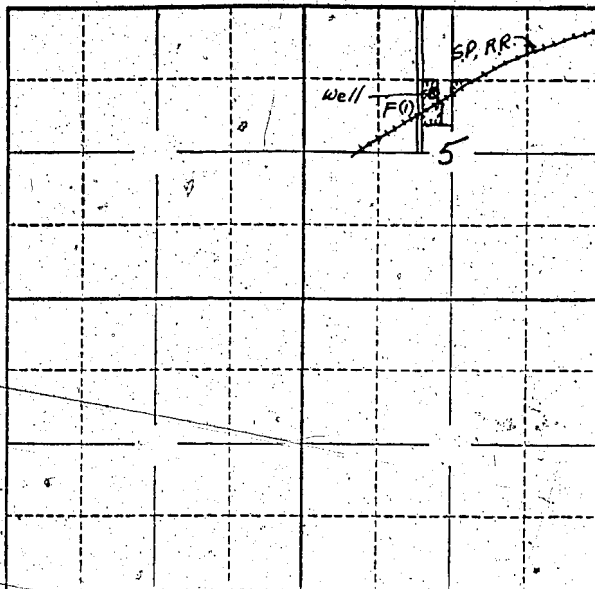

Locate well and acreage of irrigated land on plat.
Scale: 2" = 1-Mile

STATE OF OREGON

County of Washington

} ss.

I, Elva L. West, being first duly sworn, do hereby certify that I have read the foregoing Registration Statement and that all of the items therein contained are true to the best of my knowledge and belief.

Elva L. West
.....
(Signature of Registrant)

Subscribed and sworn to before me this 12 day of August, 1957, 19.....

My commission expires Dec. 6, 1960

Alan Kemp
.....
(Notary Public)

(SEAL)

CERTIFICATE OF REGISTRATION

STATE OF OREGON

County of Marion

} ss.

This is to certify that the foregoing Registration Statement was received in the office of the State Engineer on the 12 day of August, 1957, at 3:00 o'clock M. and has been duly recorded in said office in Book No. 5 of Registration Statements on page 662

Witness my hand this 24 day of April, 1958

Lewis A. Blaney
.....
(State Engineer)

By

.....
(Deputy)

GR - 862 C