

Registration Statement

OF CLAIMANT OF RIGHT TO APPROPRIATE GROUND WATER

(Under Chapter 708, Oregon Laws 1955.)

TO THE STATE ENGINEER OF OREGON:

I, Dale and Lillian Eisenmannof Rt. 1, Jefferson County of LinnState of Oregon, do hereby make application for a certificate of registration as evidence of a right to appropriate ground water.1. Source from which water is withdrawn is Pump Well No. 1
(Flowing well, pump well, infiltration trench, or tunnel)2. Location is: 3 1/2 miles SE of Jefferson, Oregon
(Approximate distance and direction from nearest city or town)

and is more particularly described as follows:

(a) N. 12° 40' W. 32.5 chains from the SE corner of NE 1/4, S. 18, T. 10 S., R. 2 W.W.M.
(Give distance and bearing to corner of section or other legal subdivision)being within NE 1/4 of NE 1/4 of Sec. 18, Twp. 10 S., Rge. 2 W.
(Smallest legal subdivision) (N. or S.) (E. or W.)

or (b) within limits of recorded platted property, town or city:

in Lot _____, Block _____ of _____
(Name of plat or addition)County of Linn

(If within city or town, give name)

3. Construction Work was begun on March 4, 1948; was completed on March 10, 1948
(Date) (Date)and the ground water claimed was first used for the purposes set out below on May 15, 1948
(Date)since which time the water has been used continuously
(Continuously or Intermittently)from May 15, 1948 to present time
(Date) (Date)4. Quantity of water claimed and used is 255 gallons per minute; 45 acre feet per year.5. Purpose or Purposes for which water is used Irrigation

(Domestic, irrigation, municipal, manufacturing, industrial, etc.)

6. Description of Well: Depth 28 feet; Type drilled

(Dug or drilled)

diameter 8 inches; Elevation of ground at well site 250 feet, mean sea level.
(As near as known)Depth to water table 8 feet.7. Capacity of Well: 400 g.p.m. with 3 feet drawdown.

_____ g.p.m. with _____ feet drawdown.

Date of test EstimatedIf Flowing Well: Measured discharge _____ g.p.m. on _____
(Date)Shut-in pressure at ground surface _____ lbs. per sq. in. on _____
(Date)Water is controlled by _____
(Cap, valve, etc.)

8. Casing: (Give diameter, commercial specifications and depth below ground surface of each casing size.)

8 inch diameter steel casing from 0 to 28 feet
inch diameter from to feet
inch diameter from to feet
inch diameter from to feet

Describe and show depth of shoe, plug, adapter, liner or other details:

9. Perforated Casings or Screens:

Slot perforations from 18 to 28
(Number per foot and size of perforations, or describe screen)
from to
from to
from to

10. Log of Well: (Describe each stratum or formation clearly, indicate if water bearing, and give thickness and depth as indicated.)

MATERIAL	Thickness (Feet)	Depth to Bottom (Feet)
Not available		

If log of well is not available, give name and address of driller. Marion West, Salem, Oregon

11. Infiltration Trench: Covered or open _____

Dimensions: Length _____ ft. Minimum depth _____ ft. Maximum depth _____ ft.

Bottom width _____ ft. Discharge _____ g.p.m. Date of test _____

12. Tunnel: Type of lining _____

Dimensions: _____
(Length, course, and cross sectional size)

Position of water bearing stratum with reference to portal of tunnel _____

Log of tunnel: (Preceding table for log of well may be used, if desired. Give footage from portal and character of materials, as pertinent.)

13. Pumping Equipment:

(a) Pump Allis Chalmers 2" centrifugal Capacity 275 g.p.m.
(Make, type and size)


(b) Motor 10 H. P. electric
(Type and horsepower)

14. Location of area irrigated or to be irrigated, or place of use if for purposes other than irrigation.

Township North or South	Range E. or W. of Willamette Meridian	Section	Forty-acre Tract	Number Acres To Be Irrigated	Date of Reclamation
10 S.	2 W.	18	NE $\frac{1}{2}$ of NE $\frac{1}{2}$	18.0	May 15, 1948

15. If the ground water supply is supplemental to an existing water supply, identification of any application for a permit, permit, certificate or adjudicated right to appropriate water made or held by the registrant.

Township 10 S Range 2 W, W.M.
North

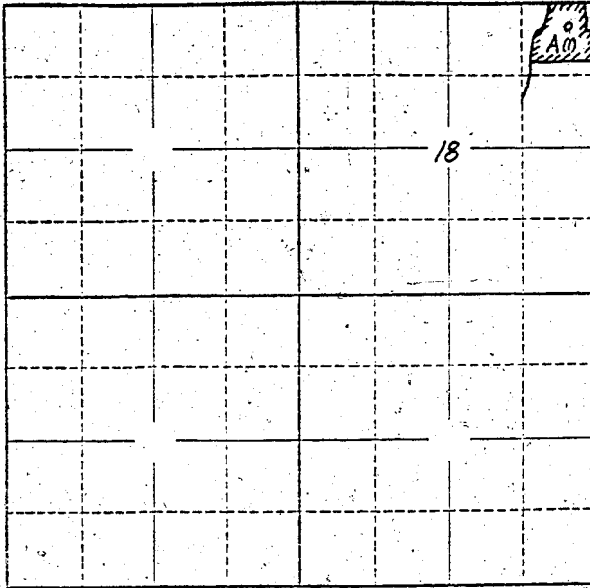

Locate well and acreage of irrigated land on plat.
Scale: 2" = 1 Mile

STATE OF OREGON

County of Linn

ss.

I, Dale and Lillian Eisenmann, being first duly sworn, do hereby certify that I have read the foregoing Registration Statement and that all of the items therein contained are true to the best of my knowledge and belief.

Dale Eisenmann
Lillian Eisenmann
(Signature of Registrant)

Subscribed and sworn to before me this 22nd day of August, 1957.

My commission expires Aug 4, 1957 *Larone Street*
(Notary Public)

(SEAL)

CERTIFICATE OF REGISTRATION

STATE OF OREGON

County of Marion

ss.

This is to certify that the foregoing Registration Statement was received in the office of the State Engineer on the 27th day of August, 1957, at 8:00 o'clock A.M. and has been duly recorded in said office in Book No. 4 of Registration Statements on page GR-562 C

~~Construction shall be completed by 10-1-58 and the water completely applied to the project by 10-1-58~~

Witness my hand this 16th day of September, 1957.

Laura A. Stanley
(State Engineer)

\$15.00

By _____ (Deputy)

GR-562 C