

Registration Statement

CERTIFICATE

GR-594

GR-564

OF CLAIMANT OF RIGHT TO APPROPRIATE GROUND WATER

(Under Chapter 703, Oregon Laws 1955.)

TO THE STATE ENGINEER OF OREGON:

I, Dale and Lillian Eisenmann
of Route 1, Jefferson County of Linn

State of Oregon, do hereby make application for a certificate of registration as evidence of a right to appropriate ground water.

1. Source from which water is withdrawn is Pump well No. 3
(Flowing well, pump well, infiltration trench, or tunnel)

2. Location is: 3 1/2 miles SE Jefferson, Oregon
(Approximate distance and direction from nearest city or town)

and is more particularly described as follows:

(a) S. 76° W. 20.75 chains from the NE corner of SE 1/4, S. 18, T. 10 S., R. 2 W.W.M.
(Give distance and bearing to corner of section or other legal subdivision)

being within NE 1/4 of SE 1/4 of Sec. 18, Twp. 10 S., Rge: 2 W.
(Smallest legal subdivision) (N. or S.) (E. or W.)

or (b) within limits of recorded platted property, town or city:

in Lot _____, Block _____ of _____
(Name of plat or addition)
(If within city or town, give name) County of Linn

3. Construction Work was begun on March 15, 1950; was completed on March 18, 1950
(Date) (Date)

and the ground water claimed was first used for the purposes set out below on May 20, 1950
(Date)

since which time the water has been used continuously
(Continuously or intermittently)

from May 20, 1950 to Present time
(Date) (Date)

4. Quantity of water claimed and used is 255 gallons per minute; 61.25 acre feet per year.

5. Purpose or Purposes for which water is used Irrigation

(Domestic, irrigation, municipal, manufacturing, industrial, etc.)

6. Description of Well: Depth 28 feet. Type drilled
(Dug or drilled)

diameter 8 inches. Elevation of ground at well site 250 feet, mean sea level.
(As near as known)

Depth to water table 10 feet.

7. Capacity of Well: 400 g.p.m. with 3 feet drawdown.
_____ g.p.m. with _____ feet drawdown.

Date of test Estimated

If Flowing Well: Measured discharge _____ g.p.m. on _____
(Date)

Shut-in pressure at ground surface _____ lbs. per sq. in. on _____
(Date)

Water is controlled by _____
(Cap, valve, etc.)

8	inch diameter	steel casing	from 0	to 28	feet
	inch diameter		from	to	feet
	inch diameter		from	to	feet
	inch diameter		from	to	feet

Slot perforations from 18 to 28
(Number per foot and size of perforations, or describe screen)

10. **Log of Well:** (Describe each stratum or formation clearly, indicate if water bearing, and give thickness and depth as indicated.)

[illegible]

If log of well is not available, give name and address of driller. Marion West, Salem, Oregon.

11. Infiltration Trench: Covered or open _____

Dimensions: Length ft. Minimum depth ft. Maximum depth ft.

Bottom width ft. Discharge g.p.m. Date of test

12. Tunnel: Type of lining -----

Dimensions: _____
(Length, course, and cross sectional size)

Position of water bearing stratum with reference to portal of tunnel

Log of tunnel: (Preceding table for log of well may be used, if desired. Give footage from portal and character of materials, as pertinent.)

13. Pumping Equipment:

(a) Pump Pacific 3" centrifugal Capacity 325 g.p.m.
(Make, type and size)


(b) Motor 10 H. P. electric
(Type and horsepower)

14. Location of area irrigated or to be irrigated, or place of use if for purposes other than irrigation.

[illegible]

15. If the ground water supply is supplemental to an existing water supply, identification of any application for a permit, permit, certificate or adjudicated right to appropriate water made or held by the registrant.

Township 10 S Range 2 E W.M.
North

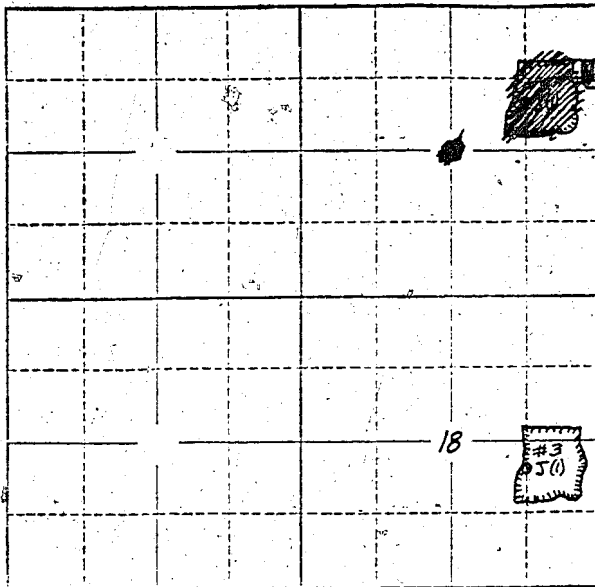

Locate well and acreage of irrigated land on plat.

Scale: 2" = 1 Mile

STATE OF OREGON

County of Linn

ss.

I, Dale and Lillian Eisenmann, being first duly sworn, do hereby certify that I have read the foregoing Registration Statement and that all of the items therein contained are true to the best of my knowledge and belief.

Dale Eisenmann
Lillian Eisenmann
(Signature of Registrant)

Subscribed and sworn to before me this 22nd day of August, 1957.

My commission expires Aug 4, 1961

Samuel Street
(Notary Public)

(SEAL)

CERTIFICATE OF REGISTRATION

STATE OF OREGON

County of Marion

ss.

This is to certify that the foregoing Registration Statement was received in the office of the State Engineer on the 27th day of August, 1957, at 8:00 o'clock A.M. and has been duly recorded in said office in Book No. 4 of Registration Statements on page GR-564 C

~~Construction shall be completed by 10-1-58 and the water completely applied to~~

~~benefit of the 12-1-58~~

Witness my hand this 16th day of September, 1957.

Lewis A. Stanley
(State Engineer)

By

(Deputy)

GR-564 C