

Registration Statement

REGISTRATION NO. GR-595CERTIFICATE NO. GR-565

OF CLAIMANT OF RIGHT TO APPROPRIATE GROUND WATER

(Under Chapter 708, Oregon Laws 1955.)

TO THE STATE ENGINEER OF OREGON:

I, Dale and Lillian Eisenmannof Route 1, Jefferson County of LinnState of Oregon, do hereby make application for a certificate of registration as evidence of a right to appropriate ground water.1. Source from which water is withdrawn is Pump Well No. 1

(Flowing well, pump well, infiltration trench, or tunnel)

2. Location is: 3 1/4 miles SE of Jefferson, Oregon

(Approximate distance and direction from nearest city or town)

and is more particularly described as follows:

(a) S. 38° 15' W. 8.5 chains from the NE corner of SE 1/4, S. 18, T. 10 S., R. 2 E. W. M.

(Give distance and bearing to corner of section or other legal subdivision)

being within NE 1/4 of SE 1/4 of Sec. 18, Twp. 10 S., Rge. 2 W.

(Smallest legal subdivision)

(N. or S.)

(E. or W.)

or (b) within limits of recorded platted property, town or city:

in Lot _____, Block _____ of _____

(Name of plat or addition)

County of Linn

(If within city or town, give name)

3. Construction Work was begun on July 10, 1955; was completed on July 12, 1955

(Date)

(Date)

and the ground water claimed was first used for the purposes set out below on July 15, 1955

(Date)

since which time the water has been used continuously

(Continuously or intermittently)

from July 15, 1955 to present time

(Date)

(Date)

4. Quantity of water claimed and used is 100 gallons per minute; 25 1/2 acre feet per year.5. Purpose or Purposes for which water is used operation of mint still, for fire protection and irrigation

(Domestic, irrigation, municipal, manufacturing, industrial, etc.)

6. Description of Well: Depth 28 feet. Type drilled

(Dug or drilled)

diameter 6 inches. Elevation of ground at well site 250 feet, mean sea level.

(As near as known)

Depth to water table 10 feet.7. Capacity of Well: 250 g.p.m. with 6 feet drawdown.

_____ g.p.m. with _____ feet drawdown.

Date of test Estimated

If Flowing Well: Measured discharge _____ g.p.m. on _____

(Date)

Shut-in pressure at ground surface _____ lbs. per sq. in. on _____

(Date)

Water is controlled by _____

(Cap, valve, etc.)

If log of well is not available, give name and address of driller.

11. Infiltration Trench: Covered or open

Dimensions: Length ft. Minimum depth ft. Maximum depth ft.

Bottom width ft. Discharge g.p.m. Date of test

12. Tunnel: Type of lining

Dimensions:

(Length, course, and cross sectional size)

Position of water bearing stratum with reference to portal of tunnel

Log of tunnel: (Preceding table for log of well may be used, if desired. Give footage from portal and character of materials, as pertinent.)

13. Pumping Equipment:

(a) Pump Pacific 1 $\frac{1}{2}$ " centrifugal Capacity 175 g.p.m.

(Make, type and size)

(b) Motor 5 H.P. electric


(Type and horsepower)

14. Location of area irrigated or to be irrigated, or place of use if for purposes other than irrigation.

Township North or South	Range E. or W. of Willamette Meridian	Section	Forty-acre Tract	Number Acres To Be Irrigated	Date of Reclamation
10 S.	2 W.	18	NE $\frac{1}{4}$ of SE $\frac{1}{4}$	operation of mint still and fire protection	July 15, 1955
10 S.	2 W.	18	NE $\frac{1}{4}$ of SE $\frac{1}{4}$	3.9	" "
10 S.	2 W.	18	SE $\frac{1}{4}$ of NE $\frac{1}{4}$	1.1	" "
				5.0	

15. If the ground water supply is supplemental to an existing water supply, identification of any application for a permit, permit, certificate or adjudicated right to appropriate water made or held by the registrant.

Township 10 S Range 2 W. W.M.
North

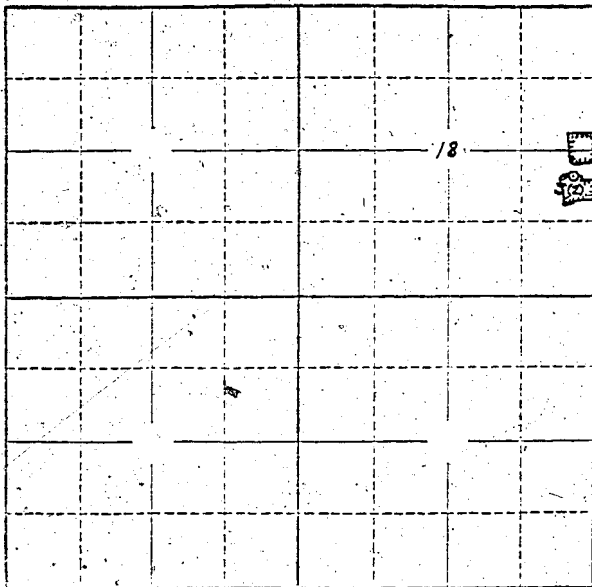

Locate well and acreage of irrigated land on plat.
Scale: 2" = 1 Mile

STATE OF OREGON

County of Linn

ss.

I, Dale and Lillian Eisenmann, being first duly sworn, do hereby certify that I have read the foregoing Registration Statement and that all of the items therein contained are true to the best of my knowledge and belief.

Dale Eisenmann
Lillian Eisenmann
(Signature of Registrant)

Subscribed and sworn to before me this 22nd day of August, 1957

My commission expires Aug 4, 1961

Saravalle Street
(Notary Public)

(SEAL)

CERTIFICATE OF REGISTRATION

STATE OF OREGON

County of Marion

ss.

This is to certify that the foregoing Registration Statement was received in the office of the State Engineer on the 27th day of August, 1957, at 8:00 o'clock A.M. and has been duly recorded in said office in Book No. 4 of Registration Statements on page GR-565 C.

~~Construction shall be completed by x-x-x-x-x-x-x-x-x-x-x-x-x-x-x-x and the water completely applied to x-x-x-x-x-x-x-x-x-x-x-x-x-x-x-x~~

Witness my hand this 16th day of September, 1957

Lawrence A. Stanley
(State Engineer)

\$ 25.00

By _____ (Deputy)

GR-565 C