

Registration Statement

REGISTRAR
CERTIFICATE

GR-597
GR-567

OF CLAIMANT OF RIGHT TO APPROPRIATE GROUND WATER

(Under Chapter 703, Oregon Laws 1955.)

TO THE STATE ENGINEER OF OREGON:

I, Leonard S. Davis
of Tigard County of Washington
State of Oregon, do hereby make application for a certificate of registration as evidence
of a right to appropriate ground water.

- 1. Source from which water is withdrawn is Pump well
(Flowing well, pump well, infiltration trench, or tunnel)
- 2. Location is: One & one-half miles South of Tigard
(Approximate distance and direction from nearest city or town)

and is more particularly described as follows: Tract of land in S.W. corner of that tract described:
The West 1/2 of the S.W. 1/4 of the S.E. 1/4 of

(a) 522' N E 245' E of 1/4 sec. corner on south line of Sec. 3, T25 R1W,
(Give distance and bearing to corner of section or other legal subdivision) Willamette Meridian, W.M.
being within SW 1/4 of SE 1/4 of Sec. 3, Twp. 7 South, Rge. 1 West of Wash. Co.
(Smallest legal subdivision) (N. or S.) (E. or W.)

or (b) within limits of recorded platted property, town or city:
in Lot _____ Block _____ of _____
(Name of plat or addition)
County of Washington
(If within city or town, give name)

3. Construction Work was begun on March 1953; was completed on March 10, 1954
(Date) (Date)
and the ground water claimed was first used for the purposes set out below on July 1954
(Date)
since which time the water has been used Intermittently
(Continuously or Intermittently)
from July 1954 to Aug 1954
(Date) (Date)

4. Quantity of water claimed and used is 60 gallons per minute; _____ acre
feet per year.

5. Purpose or Purposes for which water is used Irrigation
~~Domestic~~ Irrigation
(Domestic, irrigation, municipal, manufacturing, industrial, etc.)

6. Description of Well: Depth 215 feet. Type Drilled
(Dug or drilled)
diameter 6 inches. Elevation of ground at well site 270.15 feet, mean sea level.
(As near as known)
Depth to water table 185 feet.

7. Capacity of Well: 60 g.p.m. with _____ feet drawdown.
_____ g.p.m. with _____ feet drawdown.
Date of test 3-6-54

If Flowing Well: Measured discharge 60 g.p.m. on 3-19-54
(Date)
Shut-in pressure at ground surface _____ lbs. per sq. in. on _____
(Date)
Water is controlled by Flow stop
(Cap, valve, etc.)

8. Casing: (Give diameter, commercial specifications and depth below ground surface of each casing size.)

6 inch diameter from Ground to 16.4 feet
 6 inch diameter Basalt from 16.4 to 218 feet
 6 inch diameter from to feet
 6 inch diameter from to feet

Describe and show depth of shoe, plug, adapter, liner or other details:

9. Perforated Casings or Screens:

..... from to
(Number per foot and size of perforations, or describe screen)
 from to
 from to
 from to

10. Log of Well: (Describe each stratum or formation clearly, indicate if water bearing, and give thickness and depth as indicated.)

MATERIAL	Thickness (Feet)	Depth to Bottom (Feet)
Clay	98 Feet	
Sand	66 Feet	

If log of well is not available, give name and address of driller.

11. Infiltration Trench: Covered or open

Dimensions: Length ft. Minimum depth ft. Maximum depth ft.

Bottom width ft. Discharge g.p.m. Date of test

12. Tunnel: Type of lining

Dimensions:
(Length, course, and cross sectional size)

Position of water bearing stratum with reference to portal of tunnel

Log of tunnel: (Preceding table for log of well may be used, if desired. Give footage from portal and character of materials, as pertinent.)

13. Pumping Equipment:

(a) Pump *Sumo (Series C)* *7 1/2 HP Submersible* Capacity *60* g.p.m.
(Make, type and size)


(b) Motor *1200 S* - *7 1/2 HP*
(Type and horsepower)

14. Location of area irrigated or to be irrigated, or place of use if for purposes other than irrigation.

Township North or South	Range E. or W. of Willamette Meridian	Section	Forty-acre Tract	Number Acres To Be Irrigated	Date of Reclamation
<i>2 South</i>	<i>1 West</i>	<i>3</i>	<i>SW 1/4 of SE 1/4</i>	<i>12</i>	<i>July 1954</i>

15. If the ground water supply is supplemental to an existing water supply, identification of any application for a permit, permit, certificate or adjudicated right to appropriate water made or held by the registrant.

Township 2 S, Range 1 W, W.M.
North

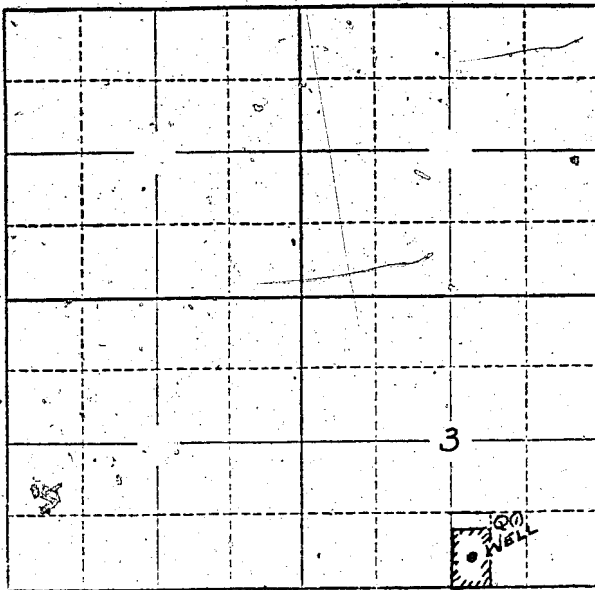

Locate well and acreage of irrigated land on plat.

Scale: 2" = 1 Mile

STATE OF OREGON

County of Washington } ss.

I, Leonard S. Davis, being first duly sworn, do hereby certify that I have read the foregoing Registration Statement and that all of the items therein contained are true to the best of my knowledge and belief.

Leonard S. Davis
(Signature of Registrant)

Subscribed and sworn to before me this 19 day of July, 19 57

My commission expires Dec 22 1957

Richard A. ...
(Notary Public)

(SEAL)

CERTIFICATE OF REGISTRATION

STATE OF OREGON

County of Marion } ss.

This is to certify that the foregoing Registration Statement was received in the office of the State Engineer on the 26th day of August, 19 57, at 1:00 o'clock P. M. and has been duly recorded in said office in Book No. 4 of Registration Statements on page GR-567 C

~~Construction shall be completed by ... of the State of Oregon ...~~

Witness my hand this 16th day of September, 19 57

Leura A. Ostrom
(State Engineer)

#1500

By _____ (Deputy)

GR-567 C