

Dec 8, 1955

REGISTRATION NO. GR-60

CERTIFICATE NO. GR-52

# Registration Statement

## OF CLAIMANT OF RIGHT TO APPROPRIATE GROUND WATER

(Under Chapter 708, Oregon Laws 1955.)

TO THE STATE ENGINEER OF OREGON:

I, CLIFFORD and GRACE LINDQUIST

of SALEM County of MARION

State of OREGON, do hereby make application for a certificate of registration as evidence of a right to appropriate ground water.

1. Source from which water is withdrawn is PUMP WELL  
(Flowing well, pump well, infiltration trench, or tunnel)

2. Location is: 5 MILES NORTH OF SALEM  
(Approximate distance and direction from nearest city or town)

and is more particularly described as follows:

(a) 16 CHS. WEST AND 7 1/2 CHS. NORTH OF 1/4 QUARTER BETWEEN SEC. 25  
(Give distance and bearing to corner of section or other legal subdivision)

being within SE 1/4 NE 1/4 of Sec. 26, Twp. 6 South, Rge. 3 WEST  
(Smallest legal subdivision) (N. or S.) (E. or W.)

or (b) within limits of recorded platted property, town or city: \_\_\_\_\_

in Lot \_\_\_\_\_ Block \_\_\_\_\_ of \_\_\_\_\_  
(Name of plat or addition)

County of \_\_\_\_\_  
(If within city or town, give name)

3. Construction Work was begun on Jan 16-1957; was completed on Feb 19-1957  
(Date) (Date)

and the ground water claimed was first used for the purposes set out below on APRIL 21-1957  
(Date)

since which time the water has been used CONTINUOUSLY  
(Continuously or intermittently)

from April 21-1957 to PRESENT TIME  
(Date) (Date)

4. Quantity of water claimed and used is 150 gallons per minute; 20 acre feet per year.

5. Purpose or Purposes for which water is used IRRIGATION AND DOMESTIC  
(Domestic, irrigation, municipal, manufacturing, industrial, etc.)

6. Description of Well: Depth 92 feet. Type DRILLED  
(Dug or drilled)

diameter 8 inches. Elevation of ground at well site 180 feet, mean sea level.  
(As near as known)

Depth to water table 72 feet.

7. Capacity of Well: 100 g.p.m. with 14 feet drawdown.

150 g.p.m. with 18 feet drawdown.

Date of test Feb 19-1957

If Flowing Well: Measured discharge \_\_\_\_\_ g.p.m. on \_\_\_\_\_  
(Date)


Shut-in pressure at ground surface \_\_\_\_\_ lbs. per sq. in. on \_\_\_\_\_  
(Date)

Water is controlled by \_\_\_\_\_  
(Cap, valve, etc.)





Township 6 South Range 3 West, W.M.  
North

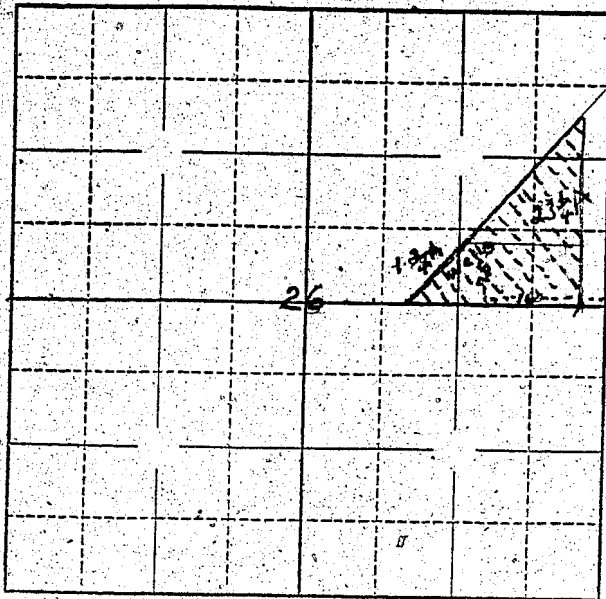

Locate well and acreage of irrigated land on plat.  
Scale: 1/4 - 1 Mile

STATE OF OREGON

County of Marion } ss.

I, Clifford Lindquist, being first duly sworn, do hereby certify that I have read the foregoing Registration Statement and that all of the items therein contained are true to the best of my knowledge and belief.

Clifford Lindquist  
(Signature of Registrant)

Subscribed and sworn to before me this 6 day of December, 1955.

My commission expires April 18, 1956.

Raymond Hoaden  
(Notary Public)

(SEAL)

**CERTIFICATE OF REGISTRATION**

STATE OF OREGON

County of Marion } ss.

This is to certify that the foregoing Registration Statement was received in the office of the State Engineer on the 8th day of December, 1955, at 8:00 o'clock A. M. and has been duly recorded in said office in Book No. 1 of Registration Statements on page 52.

Construction shall be completed by 1/5, 1956, and the water completely applied to beneficial use by 1/5, 1956.

Witness my hand this 24th day of February, 1956.

Lewis A. Stanley  
(State Engineer)

By \_\_\_\_\_  
(Deputy)