

RECEIVED  
SEP 10 1957  
STATE ENGINEER  
SALEM, OREGON

REGISTRATION NO. GR 606  
CERTIFICATE NO. 577

# Registration Statement

## OF CLAIMANT OF RIGHT TO APPROPRIATE GROUND WATER

(Under Chapter 708, Oregon Laws 1955.)

TO THE STATE ENGINEER OF OREGON:

I, Henry William and Ruby May Shakelford.

of Milton-Freewater, R/#3.Rx County of Umatilla

State of Oregon do hereby make application for a certificate of registration as evidence of a right to appropriate ground water.

1. Source from which water is withdrawn is Pump well  
(Flowing well, pump well, infiltration trench, or tunnel)

2. Location is: 1.1/2 miles  
(Approximate distance and direction from nearest city or town)

and is more particularly described as follows: Sec. 25 Tp. 6 N. R. 35 E. W. 11.

(a) 616 ft. West from apt. 330 ft. N. from the SE cor of SW 1/4 of SW 1/4  
(Give distance and bearing to corner of section or other legal subdivision)

being within SW 1/4 of the SW 1/4 of Sec. 35, Twp. 6 N., Rge. 35 E.  
(Smallest legal subdivision) (N. or S.) (E. or W.)

or (b) within limits of recorded platted property, town or city:

in Lot \_\_\_\_\_, Block bf  
(Name of plat or addition)

County of Umatilla  
(If within city or town, give name)

3. Construction Work was begun on 1916; was completed on 1916  
(Date) (Date)

and the ground water claimed was first used for the purposes set out below on 1916  
(Date)

since which time the water has been used continuously  
(Continuously or intermittently)

from 1916 to July 11th 1956  
(Date) (Date)

4. Quantity of water claimed and used is 225 gallons per minute; 50 acre feet per year.

5. Purpose or Purposes for which water is used Irrigation

(Domestic, irrigation, municipal, manufacturing, industrial, etc.)

6. Description of Well: Depth 65 feet. Type Dug 36', drilled 27 ft.  
(Dug or drilled)

Dug part 5'x5' diameter 3" inches. Elevation of ground at well site about 900 feet, mean sea level.  
(As near as known)

Depth to water-table \_\_\_\_\_ feet.

7. Capacity of Well: 260 g.p.m. with \_\_\_\_\_ feet drawdown.

\_\_\_\_\_ g.p.m. with \_\_\_\_\_ feet drawdown.

Date of test unknown

If Flowing Well: Measured discharge \_\_\_\_\_ g.p.m. on \_\_\_\_\_ (Date)

Shut-in pressure at ground surface \_\_\_\_\_ lbs. per sq. in. on \_\_\_\_\_ (Date)

Water is controlled by \_\_\_\_\_  
(Cap, valve, etc.)



If log of well is not available, give name and address of driller: .....

11. Infiltration Trench: Covered or open .....

Dimensions: Length ..... ft. Minimum depth ..... ft. Maximum depth ..... ft.

Bottom width ..... ft. Discharge ..... g.p.m. Date of test .....

12. Tunnel: Type of lining .....

Dimensions: .....  
(Length, course, and cross sectional size)

Position of water bearing stratum with reference to portal of tunnel .....

Log of tunnel: (Preceding table for log of well may be used, if desired. Give footage from portal and character of materials, as pertinent.)

13. Pumping Equipment:

(a) Pump: 2, 1/3 " centrifugal ..... Capacity 225 ..... g.p.m.  
(Make, type and size)


(b) Motor: 5 H.P. 3 phase .....  
(Type and horsepower)

14. Location of area irrigated or to be irrigated, or place of use if for purposes other than irrigation.

Township North or South	Range E. or W. of Willamette Meridian	Section	Forty-acre Tract	Number Acres To Be Irrigated	Date of Reclamation
6N	35E	25	SW <sup>4</sup> of SW <sup>4</sup>	5.0	1912

15. If the ground water supply is supplemental to an existing water supply, identification of any application for a permit, permit, certificate or adjudicated right to appropriate water made or held by the registrant.

Township 6N Range 35E, W.M.  
North

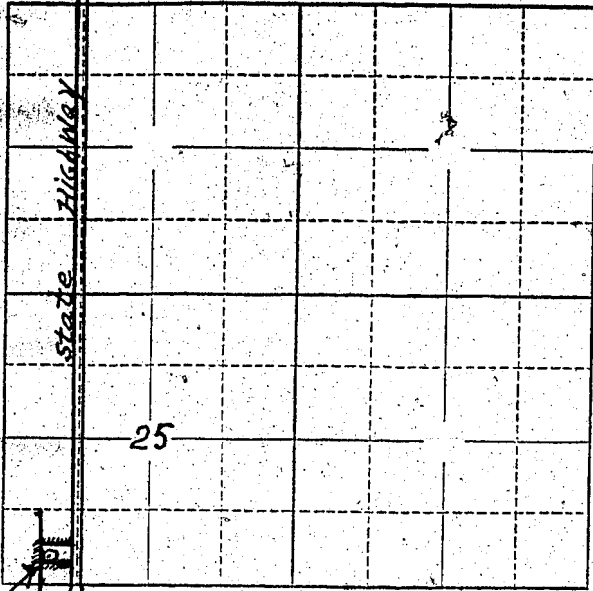

Well  
Locate well and acreage of irrigated land on plat.  
Scale: 2" = 1 Mile

STATE OF OREGON  
County of Umatilla } ss.

I, Henry William Shakelford, being first duly sworn, do hereby certify that I have read the foregoing Registration Statement and that all of the items therein contained are true to the best of my knowledge and belief.

Henry William Shakelford  
(Signature of Registrant)

Subscribed and sworn to before me this 6th day of September, 1957

My commission expires August 19, 1957  
(Notary Public)

(SEAL)

**CERTIFICATE OF REGISTRATION**

STATE OF OREGON } ss.  
County of Marion

This is to certify that the foregoing Registration Statement was received in the office of the State Engineer on the 10th day of September, 1957, at 1:00 o'clock P.M. and has been duly recorded in said office in Book No. 4 of Registration Statements on page GR-577 C.

Construction shall be completed by x-x-x-x-x-x-x-x-10-x-x and the water completely applied to beneficial use by x-x-x-x-x-x-x-x-19-x-x-x.

Witness my hand this 16th day of October, 1957.

Lewis A. Starnes  
(State Engineer)

\$ 15.00

By \_\_\_\_\_  
(Deputy)

GR-577 C