

RECEIVED
SEP 11 1952
STATE ENGINEER
SALEM, OREGON

Registration No. GR-608

Certificate No. GR 579

Registration Statement

OF CLAIMANT OF RIGHT TO APPROPRIATE GROUND WATER

TO THE STATE ENGINEER OF OREGON:

I, Donald W. and May E. Worden

of Route 2, Box 109, Scio County of Linn
(Mailing address)

State of Oregon, do hereby make application for a certificate of registration as evidence of a right to appropriate ground water.

1. Source from which water is withdrawn is pump well
(Flowing well, pump well, infiltration trench, or tunnel)

2. Location is: 3 miles west of Scio, Oregon
(Approximate distance and direction from nearest city or town)

and is more particularly described as follows:

(a) S. 31 1/2° E. 15.5 chains from NW corner of SW 1/4 of S. 11, T. 10 S., R 2W
(Give distance and bearing to corner of section or other legal subdivision)

being within NW 1/4 of SW 1/4 of Sec. 11, Twp. 10 S., Rge. 2W
(Smallest legal subdivision) (N. or S.) (E. or W.)

or (b) within limits of recorded platted property, town or city:

in Lot _____, Block _____ of _____
(Name of plat or addition)

County of Linn
(If within city or town, give name)

3. Construction Work was begun on May 1952; was completed on May 1952
(Date) (Date)

and the ground water claimed was first used for the purposes set out below on June 1952
(Date)

since which time the water has been used continuously
(Continuously or intermittently)

from June 1952 to present time
(Date) (Date)

4. Quantity of water claimed and used is 150 gallons per minute; 67.5 acre feet per year.

5. Purpose or Purposes for which water is used Irrigation
(Domestic, irrigation, municipal, manufacturing, industrial, etc.)

6. Description of Well: Depth 72 feet. Type drilled
(Dug or drilled)

diameter 10 inches. Elevation of ground at well site 305 feet, mean sea level.
(As near as known)

Depth to water table 12 feet.

7. Capacity of Well: 500 g.p.m. with 3 feet drawdown.

_____ g.p.m. with _____ feet drawdown.


Date of test June 1952

If Flowing Well: Measured discharge _____ g.p.m. on _____
(Date)

Shut-in pressure at ground surface _____ p.s.f. in. on _____
(Date)

Water is controlled by _____
(Cap, valve, etc.)

Township 10 S. Range 2W, W.M.
North

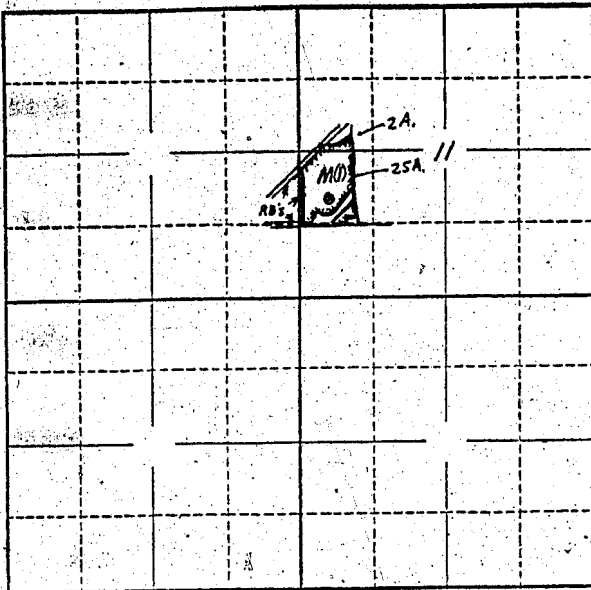

Locate well and acreage of irrigated land on plat.

Scale: 2" = 1 Mile

STATE OF OREGON

County of Linn

} ss.

I, Donald W. and May E. Worden, being first duly sworn, do hereby certify that I have read the foregoing Registration Statement and that all of the items therein contained are true to the best of my knowledge and belief.

Donald W. and May E. Worden
(Signature of Registrant)

Subscribed and sworn to before me this 7 day of September, 1957

My commission expires 12/4/59

[Signature]
(Notary Public)

(SEAL)

CERTIFICATE OF REGISTRATION

STATE OF OREGON

County of Marion

} ss.

This is to certify that the foregoing Registration Statement was received in the office of the State Engineer on the 10th day of September, 1957, at 8:00 o'clock A. M. and has been duly recorded in said office in Book No. 4 of Registration Statements on page GR-579 C

Witness my hand this 16th day of October, 1957.

Lewis A. Stanley
(State Engineer)

By

(Deputy)

GR - 579 C