

RECEIVED
NOV 25 1955
STATE ENGINEER
SALEM, OREGON

REGISTRATION NO. GR-61
CERTIFICATE NO. GR-53

Registration Statement

OF CLAIMANT OF RIGHT TO APPROPRIATE GROUND WATER

(Under Chapter 708, Oregon Laws 1955.)

TO THE STATE ENGINEER OF OREGON:

I, OREGON STATE BOARD OF CONTROL

of SALEM County of MARION

State of OREGON do hereby make application for a certificate of registration as evidence of a right to appropriate ground water.

1. Source from which water is withdrawn is Infiltration trench and tile lines
(Flowing well, pump well, infiltration trench, or tunnel)

2. Location is: 6 miles southeast of Salem, Oregon
(Approximate distance and direction from nearest city or town)

and is more particularly described as follows:

(a) Pump station is 490' N. and 380' E. from the SW 1/4 cor. of Sec. 8
(Give distance and bearing to corner of section or other legal subdivision)

being within Sec. 8 of Sec. 7, 23, 17, Twp. 8S, Rge. 2 W. 11E
(Smallest legal subdivision) (N. or S.) (E. or W.)

or (b) within limits of recorded platted property, town or city:

in Lot , Block of
(Name of plat or addition)

 County of
(If within city or town, give name)

3. Construction Work was begun on March 1, 1954; was completed on Apr. 30, 1954
(Date) (Date)

and the ground water claimed was first used for the purposes set out below on September 30, 1957
(Date)

since which time the water has been used Continuously
(Continuously or Intermittently)

from May 15, 1955 to Sept. 30, 1955
(Date) (Date)

4. Quantity of water claimed and used is 561.6 gallons per minute; 260 acre feet per year.

5. Purpose or Purposes for which water is used irrigation

(Domestic, irrigation, municipal, manufacturing, industrial, etc.)

6. Description of Well: Depth feet. Type
(Dug or drilled)

diameter inches. Elevation of ground at well site 330' feet, mean sea level.
(As near as known)

Depth to water table feet.

7. Capacity of Well: g.p.m. with feet drawdown.

 g.p.m. with feet drawdown.

Date of test

If Flowing Well: Measured discharge g.p.m. on (Date)

Shut-in pressure at ground surface lbs. per sq. in. on (Date)

Water is controlled by
(Cap, valve, etc.)

If log of well is not available, give name and address of driller.

11. Infiltration Trench: Covered or open Both (See attached sketch for tile line and ditch layout.)
 Dimensions: Length 17,000 ft. Minimum depth 20 ft. Maximum depth 24 ft.
 Bottom width 4 to 10 ft. Discharge 561.6 g.p.m. Date of test Oct. 1, 1955

12. Tunnel: Type of lining
 Dimensions:
 (Length, course, and cross sectional size)
 Position of water bearing stratum with reference to portal of tunnel

Log of tunnel: (Preceding table for log of well may be used, if desired. Give footage from portal and character of materials, as pertinent.)


13. Pumping Equipment:
 (a) Pump Ingersoll Rand Centrifugal 4" intake 3" Outlet Capacity 5.0 g.p.m.
 (Make, type and size)
 (b) Motor Electric 3 phase 40 HP
 (Type and horsepower)

14. Location of area irrigated or to be irrigated, or place of use if for purposes other than irrigation.

Township North or South	Range E. or W. of Willamette Meridian	Section	Forty-acre Tract	Number Acres To Be Irrigated	Date of Reclamation
8 S	2 W	7	NE 33	3.5	9/30/57
8 S	2 W	7	NW 33	4.5	"
8 S	2 W	7	SE 33	3.5	"
8 S	2 W	7	SW 33	2	"
		8	SE 34	3.5	5/15/54
		8	SW 34	1	"
		17	NE 34	3.5	"
		17	NW 34	3	"
		17	SE 34	1	"
		17	SW 34	2	"
		18	SE 35	3	9/30/57
				120.0	

15. If the ground water supply is supplemental to an existing water supply, identification of any application for a permit, permit, certificate or adjudicated right to appropriate water made or held by the registrant.

Township 8S Range 2W W.M.
North

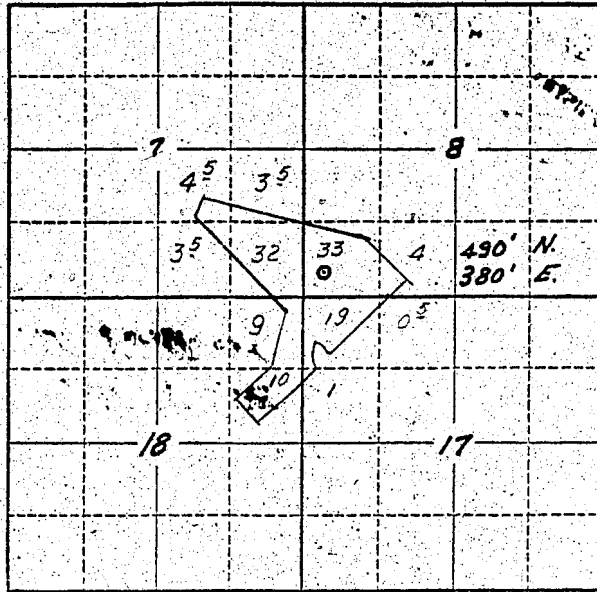

Locate well and acreage of irrigated land on plat.
Scale: 2" = 1 Mile

STATE OF OREGON }
County of Marion } ss.

I, E. J. Inland, Secy, Oregon State Board of Control, being first duly sworn, do hereby certify that I have read the foregoing Registration Statement and that all of the items therein contained are true to the best of my knowledge and belief.

E. J. Inland
(Signature of Registrant)

Subscribed and sworn to before me this 8th day of December, 1955

My commission expires July 1 - 1957
(Notary Public)

(SEAL)

CERTIFICATE OF REGISTRATION

STATE OF OREGON }
County of Marion } ss.

This is to certify that the foregoing Registration Statement was received in the office of the State Engineer on the 9th day of December, 1955, at 8:00 o'clock A.M. and has been duly recorded in said office in Book No. 1 of Registration Statements on page 53

Construction shall be completed by 9/27/ 1957, and the water ^{will be} completely applied to beneficial use by 9/27/ 1957.

Witness my hand this 24th day of February, 1956

Lewis A. Stanley
(State Engineer)

By _____ (Deputy)