

Registration Statement

OF CLAIMANT OF RIGHT TO APPROPRIATE GROUND WATER

TO THE STATE ENGINEER OF OREGON:

Re: Tigard Well No. 2

TIGARD WATER DISTRICT

I, By O. E. JANOE, Chairman, Board of Commissioners

of 8900 S.W. Burnham Ave., Tigard County of Washington

(Mailing address)

State of Oregon do hereby make application for a certificate of registration as evidence of a right to appropriate ground water.

1. Source from which water is withdrawn is pump well #2 (Flowing well, pump well, infiltration trench, or tunnel)

2. Location is: 1 1/2 miles southwest of Tigard, Oregon (Approximate distance and direction from nearest city or town)

and is more particularly described as follows:

(a) South 610 ft. and East 1270 ft. from NW corner of Section 10 (Give distance and bearing to corner of section or other legal subdivision)

being within NW 1/4 NW 1/4 of Sec. 10, Twp. 2 S., Rge. 1 W. (Smallest legal subdivision) (N. or S.) (E. or W.)

or (b) within limits of recorded platted property, town or city:

in Lot _____, Block _____ of _____ (Name of plat or addition)

(If within city or town, give name) _____ County of _____

3. Construction Work was begun on 1949 (Date); was completed on July 30, 1957 (Date) 1949 Enc

and the ground water claimed was first used for the purposes set out below on September, 1949 (Date)

since which time the water has been used continuously (Continuously or intermittently)

from Sept., 1949 to Sept., 1957 (Date) (Date)

4. Quantity of water claimed and used is 500 gallons per minute; _____ acre feet per year.

5. Purpose or Purposes for which water is used municipal (Domestic, irrigation, municipal, manufacturing, industrial, etc.)

6. Description of Well: Depth 453 feet. Type Drilled (Dug or drilled)

diameter 12 inches. Elevation of ground at well site 400 375 feet, mean sea level. (As near as known)

Depth to water table 190 feet.

7. Capacity of Well: 325 g.p.m. with 72 feet drawdown.

400 g.p.m. with 90 feet drawdown. Pumped 700 gpm for 24 hrs.

Date of test July, 1949

If Flowing Well: Measured discharge _____ g.p.m. on _____ (Date)

Shut-in pressure at ground surface _____ lbs. per sq. in. on _____ (Date)

Water is controlled by _____ (Cap, valve, etc.)

If log of well is not available, give name and address of driller.

11. Infiltration Trench: Covered or open

Dimensions: Length ft. Minimum depth ft. Maximum depth ft.

Bottom width ft. Discharge g.p.m. Date of test

12. Tunnel: Type of lining

Dimensions:
(Length, course, and cross sectional size)

Position of water bearing stratum with reference to portal of tunnel

Log of tunnel: (Preceding table for log of well may be used, if desired. Give footage from portal and character of materials, as pertinent.)

13. Pumping Equipment:

(a) Pump Peerless deep well turbine Capacity 500 Capacity 500 g.p.m.
(Make, type and size)

(b) Motor Electric, 220V, 1760 rpm, 15 HP
(Type and horsepower)


14. Location of area irrigated or to be irrigated, or place of use if for purposes other than irrigation.

Township North or South	Range E. or W. of Willamette Meridian	Section	Forty-acre Tract	Number Acres To Be Irrigated	Date of Reclamation
1 S.	1 W.	34	S $\frac{1}{2}$	Municipal	1949
2 S.	1 W.	2	All	"	"
"	"	3	All	"	"
"	"	9	N $\frac{1}{2}$	"	"
"	"	10	N $\frac{1}{2}$	"	"
"	"	11	N $\frac{1}{2}$	"	"

15. If the ground water supply is supplemental to an existing water supply, identification of any application for a permit, permit, certificate or adjudicated right to appropriate water made or held by the registrant.

Tigard Well No. 1 being registered.

Township 2 S Range 1 W, W.M.
North

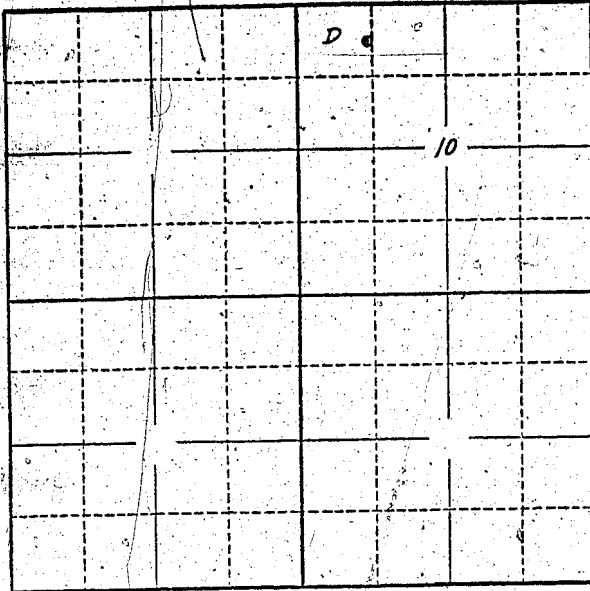

Locate well and acreage of irrigated land on plat.

Scale: 2" = 1 Mile

STATE OF OREGON

County of Washington

ss.

I, G. E. JANOE, being first duly sworn, do hereby certify that I have read the foregoing Registration Statement and that all of the items therein contained are true to the best of my knowledge and belief.

G. E. Janoe
Chairman (Signature of Registrant)
Board of Commissioners

Subscribed and sworn to before me this 9th day of September, 1957

My commission expires Feb 7, 1960

Fred Anderson
(Notary Public)

(SEAL)

CERTIFICATE OF REGISTRATION

STATE OF OREGON

County of Marion

ss.

This is to certify that the foregoing Registration Statement was received in the office of the State Engineer on the 16th day of September, 19 57, at 8:00 o'clock A. M. and has been duly recorded in said office in Book No. 4 of Registration Statements on page GR-587 C.

Witness my hand this 16th day of October, 19 57.

Lewis A. Stanley
(State Engineer)

By

(Deputy)

GR - 587 C