

# Registration Statement

## OF CLAIMANT OF RIGHT TO APPROPRIATE GROUND WATER

TO THE STATE ENGINEER OF OREGON:

Re: Tigard Well No. 1

### TIGARD WATER DISTRICT

I, By C. E. JANOE, Chairman, Board of Commissioners

of 8900 S.W. Burnham Ave., Tigard County of Washington

(Mailing address)

State of Oregon, do hereby make application for a certificate of registration as evidence of a right to appropriate ground water.

1. Source from which water is withdrawn is pump well #1  
(Flowing well, pump well, infiltration trench, or tunnel)
2. Location is: One mile southwest of Tigard, Oregon  
(Approximate distance and direction from nearest city or town)

and is more particularly described as follows:

(a) South 1625 ft. and East 30 ft. from NW corner of Section 11  
(Give distance and bearing to corner of section or other legal subdivision)  
being within S.W. 1/4 NW 1 of Sec. 11, Twp. 2 S., Rge. 1 W.  
(Smallest legal subdivision) (N. or S.) (E. or W.)

or (b) within limits of recorded platted property, town or city: \_\_\_\_\_  
in Lot \_\_\_\_\_, Block \_\_\_\_\_ of \_\_\_\_\_  
(Name of plat or addition)

(If within city or town, give name)

County of \_\_\_\_\_

3. Construction Work was begun on \_\_\_\_\_; was completed on April 25, 1947  
(Date) (Date)

and the ground water claimed was first used for the purposes set out below on July 1, 1947  
(Date)  
since which time the water has been used continuously  
(Continuously or intermittently)  
from July 1, 1947 to Sept., 1957  
(Date) (Date)

4. Quantity of water claimed and used is 200 gallons per minute; \_\_\_\_\_ acre feet per year.

5. Purpose or Purposes for which water is used municipal  
(Domestic, irrigation, municipal, manufacturing, industrial, etc.)

6. Description of Well: Depth 381 feet. Type Drilled  
(Dug or drilled)  
diameter 12 inches. Elevation of ground at well site 400 403 feet, mean sea level.  
(As near as known)  
Depth to water table 188 feet.

7. Capacity of Well: 170 g.p.m. with 46 feet drawdown.  
210 g.p.m. with 97 feet drawdown.

Date of test April, 1947

If Flowing Well: Measured discharge \_\_\_\_\_ g.p.m. on \_\_\_\_\_  
(Date)

Shut-in pressure at ground surface \_\_\_\_\_ lbs. per sq. in. on \_\_\_\_\_  
(Date)

Water is controlled by \_\_\_\_\_  
(Cap, valve, etc.)

8. Casing: (Give diameter, commercial specifications and depth below ground surface of each casing size.)

12 inch diameter standard steel from surface to 71 feet  
inch diameter from to feet  
inch diameter from to feet  
inch diameter from to feet

Describe and show depth of shoe, plug, adapter, liner or other details: \_\_\_\_\_  
\_\_\_\_\_

### 9. Perforated Casings or Screens:

(Number per foot and size of perforations, or describe screen)  
from to  
from to  
from to  
from to

10. Log of Well: (Describe each stratum or formation clearly, indicate if water bearing, and give thickness and depth as indicated.) **Log attached**

MATERIAL	Thickness (Feet)	Depth to Bottom (Feet)

If log of well is not available, give name and address of driller. ....

11. Infiltration Trench: Covered or open .....  
 Dimensions: Length ..... ft. Minimum depth ..... ft. Maximum depth ..... ft.  
 Bottom width ..... ft. Discharge ..... g.p.m. Date of test .....
12. Tunnel: Type of lining .....  
 Dimensions: .....  
(Length, course, and cross sectional size)  
 Position of water bearing stratum with reference to portal of tunnel .....

Log of tunnel: (Preceding table for log of well may be used, if desired. Give footage from portal and character of materials, as pertinent.)


13. Pumping Equipment:  
 (a) Pump ..... **15 stage Peerless deep well turbine** Capacity **250** (g.p.m.) g.p.m.  
(Make, type and size)  
 (b) Motor ..... **Electric, 220V, 1760 rpm, 15 HP**  
(Type and horsepower)

14. Location of area irrigated or to be irrigated, or place of use if for purposes other than irrigation.

Township North or South	Range E. or W. of Willamette Meridian	Section	Forty-acre Tract	Number Acres To Be Irrigated	Date of Reclamation
1 S.	1 W.	34	S $\frac{1}{2}$	Municipal	1947
2 S.	1 W.	2	All	"	"
"	"	3	All	"	"
"	"	9	N $\frac{1}{2}$	"	"
"	"	10	N $\frac{1}{2}$	"	"
"	"	11	N $\frac{1}{2}$	"	"

15. If the ground water supply is supplemental to an existing water supply, identification of any application for a permit, permit, certificate or adjudicated right to appropriate water made or held by the registrant.  
**Tigard Well No. 2 being registered.**

Township 25 Range 1W, W.M.  
North

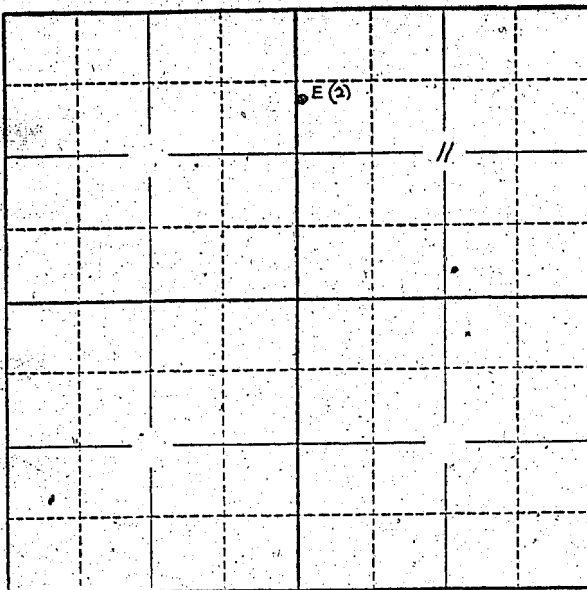

Locate well and acreage of irrigated land on plat.  
Scale: 2" = 1 Mile

STATE OF OREGON

County of Washington } ss.

I, C. E. JANOE, being first duly sworn, do hereby certify that I have read the foregoing Registration Statement and that all of the items therein contained are true to the best of my knowledge and belief.

C. E. Janoe  
Chairman  
(Signature of Registrant)  
Board of Commissioners

Subscribed and sworn to before me this 9th day of September, 1957

My commission expires Feb 7, 1960

L. A. Anderson  
(Notary Public)

(SEAL)

### CERTIFICATE OF REGISTRATION

STATE OF OREGON

County of Marion } ss.

This is to certify that the foregoing Registration Statement was received in the office of the State Engineer on the 16th day of September, 1957, at 8:00 o'clock A. M. and has been duly recorded in said office in Book No. 4 of Registration Statements on page GR-588 C.

Witness my hand this 16th day of October, 1957.

Lewis A. Stanley  
(State Engineer)

By \_\_\_\_\_

(Deputy)

GR - 588 C