

# Registration Statement

OF CLAIMANT OF RIGHT TO APPROPRIATE GROUND WATER

RECEIVED  
NOV 18 1957  
STATE ENGINEER  
SALEM, OREGON

(Under Chapter 708, Oregon Laws 1955.)

TO THE STATE ENGINEER OF OREGON:

I, Martin J. Zitek  
of Seaside County of Cat

State of Ore, do hereby make application for a certificate of registration as evidence of a right to appropriate ground water.

1. Source from which water is withdrawn is Pump well  
(Flowing well, pump well, infiltration trench, or tunnel)

2. Location is: 1/2 mi S. of Seaside  
(Approximate distance and direction from nearest city or town)

and is more particularly described as follows:

(a) 100 feet east of and 1200 feet north from the SW corner Section 13  
SW 1/4 of SE 1/4 (Give distance and bearing to corner of section or other legal subdivision)

being within 1/4 of Sec. 13, Twp. 3N, Rge. 2W  
(Smallest legal subdivision) (N. or S.) (E. or W.)

or (b) within limits of recorded platted property, town or city:

in Lot \_\_\_\_\_, Block \_\_\_\_\_ of \_\_\_\_\_  
(Name of plat or addition)

County of \_\_\_\_\_  
(If within city or town, give name)

3. Construction Work was begun on April 1952, was completed on June 1952  
(Date) (Date)

and the ground water claimed was first used for the purposes set out below on June 1952  
(Date)

since which time the water has been used Continuously  
(Continuously or intermittently)

from 1952 to 1957  
(Date) (Date)

4. Quantity of water claimed and used is 25 gallons per minute; 1 acre feet per year.

5. Purpose or Purposes for which water is used Domestic  
(Domestic, irrigation, municipal, manufacturing, industrial, etc.)

6. Description of Well: Depth 170 feet. Type Drilled  
(Dug or drilled)

diameter 6 inches. Elevation of ground at well site \_\_\_\_\_ feet, mean sea level.  
(As near as known)

Depth to water table 47 feet.

7. Capacity of Well: 415 g.p.m. with 53 feet drawdown.  
\_\_\_\_\_ g.p.m. with \_\_\_\_\_ feet drawdown.

Date of test May 52

If Flowing Well: Measured discharge \_\_\_\_\_ g.p.m. on \_\_\_\_\_  
(Date)

Shut-in pressure at ground surface \_\_\_\_\_ lbs. per sq. in. on \_\_\_\_\_  
(Date)

Water is controlled by \_\_\_\_\_  
(Cap, valve, etc.)

8. Casing: (Give diameter, commercial specifications and depth below ground surface of each casing size.)

6 inch diameter ..... Top ..... from ..... to 170 feet  
 ..... inch diameter ..... from ..... to ..... feet  
 ..... inch diameter ..... from ..... to ..... feet  
 ..... inch diameter ..... from ..... to ..... feet

Describe and show depth of shoe, plug, adapter, liner or other details: .....

.....

9. Perforated Casings or Screens:

..... from ..... to .....

(Number per foot and size of perforations, or describe screen)

..... from ..... to .....

..... from ..... to .....

..... from ..... to .....

10. Log of Well: (Describe each stratum or formation clearly, indicate if water bearing, and give thickness and depth as indicated.)

MATERIAL	Thickness (Feet)	Depth to Bottom (Feet)
<u>Soil</u>	<u>14</u>	
<u>Rock</u>	<u>6</u>	
<u>Gravel sand</u>	<u>154</u>	

If log of well is not available, give name and address of driller. \_\_\_\_\_

11. Infiltration Trench: Covered or open \_\_\_\_\_

Dimensions: Length \_\_\_\_\_ ft. Minimum depth \_\_\_\_\_ ft. Maximum depth \_\_\_\_\_ ft.

Bottom width \_\_\_\_\_ ft. Discharge \_\_\_\_\_ g.p.m. Date of test \_\_\_\_\_

12. Tunnel: Type of lining \_\_\_\_\_

Dimensions: \_\_\_\_\_  
(Length, course, and cross sectional size)

Position of water bearing stratum with reference to portal of tunnel \_\_\_\_\_

Log of tunnel: (Preceding table for log of well may be used, if desired. Give footage from portal and character of materials, as pertinent.)

13. Pumping Equipment:

(a) Pump Pacific Deep Well Turbine Capacity 45 g.p.m.  
(Make, type and size)


(b) Motor 3 HP Single Phase Electric 220 V.  
(Type and horsepower)

14. Location of area irrigated or to be irrigated, or place of use if for purposes other than irrigation.

Township North or South	Range E. or W. of Willamette Meridian	Section	Forty-acre Tract	Number Acres To Be Irrigated	Date of Reclamation
3N	2W	13	S1/4 of SE 1/4	3 1/2 Acres	June 1952

15. If the ground water supply is supplemental to an existing water supply, identification of any application for a permit, permit, certificate or adjudicated right to appropriate water made or held by the registrant.

Township 3 N Range 2 W W.M.  
North

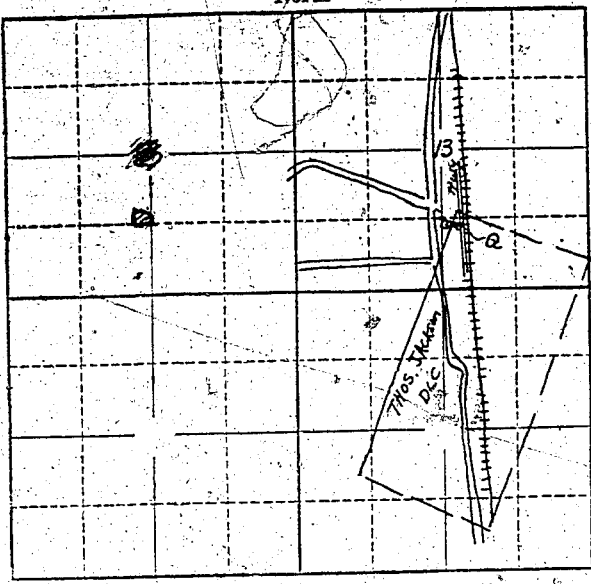

Locate well and acreage of irrigated land on plat.  
Scale: 2" = 1 Mile

STATE OF OREGON }  
County of \_\_\_\_\_ } ss.

I, \_\_\_\_\_, being first duly sworn, do hereby certify that I have read the foregoing Registration Statement and that all of the items therein contained are true to the best of my knowledge and belief.

Martin J. Jank  
(Signature of Registrant)

Subscribed and sworn to before me this 11 day of September 1957

My commission expires 11-22-59

Paul Johnson  
(Notary Public)

(SEAL)

**CERTIFICATE OF REGISTRATION**

STATE OF OREGON }  
County of Marion } ss.

This is to certify that the foregoing Registration Statement was received in the office of the State Engineer on the 12th day of September, 1957, at 8.00 o'clock A.M. and has been duly recorded in said office in Book No. 7 of Registration Statements on page GR-1514

~~Construction shall be completed by \_\_\_\_\_ 19\_\_\_\_ and the water completely applied to beneficial use by \_\_\_\_\_ 19\_\_\_\_.~~

Witness my hand this \_\_\_\_\_ 1st \_\_\_\_\_ day of \_\_\_\_\_ December \_\_\_\_\_, 1958

Lewis A. [Signature]  
(State Engineer)

\$15.00

By \_\_\_\_\_ (Deputy)

GR-1514