RECEIVED
SEP 27 1957
STATE ENGINEER
SALEM, OREGON

Registration No. GR 623

Certificate No. GR 591

Registration Statement

OF CLAIMANT OF RIGHT TO APPROPRIATE GROUND WATER

TO THE STATE ENGINEER OF OREGON:

I, WARREN L. CALLAWAY,

of R.F.D. #1, Box #72, WOODBURN (Mailing address) County of MARION

State of OREGON, do hereby make application for a certificate of registration as evidence of a right to appropriate ground water.

1. **Source** from which water is withdrawn is PUMP WELL (Flowing well, pump well, infiltration trench, or tunnel)

2. **Location** is: 2 MI. NORTH OF WOODBURN - 500 FT. EAST OF HWY 99E (Approximate distance and direction from nearest city or town)

and is more particularly described as follows:

(a) 12½ CHAINS N. & 26½ CHAINS E. FROM SW CORNER SECTION 4. (Give distance and bearing to corner of section or other legal subdivision)

being within SE¼ SW¼ (Smallest legal subdivision) of Sec. 4, Twp. 5S (N. or S.), Rge. 1W (E. or W.)

or (b) within limits of recorded platted property, town or city:

in Lot ____, Block ____ of ____ (Name of plat or addition)

____ (If within city or town, give name) County of ____

3. **Construction Work** was begun on AUG 1, 1950 (Date); was completed on AUG. 11, 1950 (Date) and the ground water claimed was first used for the purposes set out below on AUG. 11 1950 (Date), since which time the water has been used INTERMITTENTLY (Continuously or intermittently) from APRIL 1ST (Date) to SEPT. 30 (Date) EACH YEAR.

4. **Quantity** of water claimed and used is 350 gallons per minute; 3± acre feet per year.

5. **Purpose or Purposes** for which water is used DOMESTIC & IRRIGATION. (Domestic, irrigation, municipal, manufacturing, industrial, etc.)

6. **Description of Well:** Depth 129½ feet. Type DRILLED (Dug or drilled) diameter 10 inches. Elevation of ground at well site 182 (As near as known) feet, mean sea level. Depth to water table 20 feet.

7. **Capacity of Well:** 350 g.p.m. with 40 feet drawdown.

____ g.p.m. with ____ feet drawdown.

Date of test AUG. 9, 1950

If Flowing Well: Measured discharge ____ g.p.m. on ____ (Date)

Shut-in pressure at ground surface ____ lbs. per sq. in. on ____ (Date)

Water is controlled by ____ (Cap, valve, etc.)

4M—4-57

8. **Casing:** (Give diameter, commercial specifications and depth below ground surface of each casing size.)

10 inch diameter ASTM A-53 3/20 lbs from 0 to 129 1/2 feet

..... inch diameter ..... from ..... to ..... feet

..... inch diameter ..... from ..... to ..... feet

..... inch diameter ..... from ..... to ..... feet

Describe and show depth of shoe, plug, adapter, liner or other details: .....

9. **Perforated Casings or Screens:**

No. # 14 ~~ph~~ FOOT 1 1/2" LENGTH 3/8" WIDE from 117 FT. to 129 FT.
(Number per foot and size of perforations, or describe screen)

..... from ..... to .....

..... from ..... to .....

..... from ..... to .....

10. **Log of Well:** (Describe each stratum or formation clearly, indicate if water bearing, and give thickness and depth as indicated.)

MATERIAL	Thickness (Feet)	Depth to Bottom (Feet)
FROM TOP GROUND LEVEL (READ DOWN)		
TOP SOIL & YELLOW SILT.	30 FT.	
BLUE CLAY 30 FT. TO 60 FT. LEVEL	30 FT.	
BLACK SAND 60 FT. TO 85 FT. LEVEL	25 FT.	
BLUE CLAY 85 FT. TO 105 FT. LEVEL	20 FT.	
BLACK WATER SAND 105 FT. TO 117 FT. & SMALL GRAVEL.	12 FT.	
BROWN SAND & 117 FT. TO 129 FT SMALL GRAVEL.	12 FT.	

If log of well is not available, give name and address of driller. FRED WYMORE R.F.D. #2 SALEM, OREGON

11. **Infiltration Trench:** Covered or open .....

Dimensions: Length ..... ft. Minimum depth ..... ft. Maximum depth ..... ft.

Bottom width ..... ft. Discharge ..... g.p.m. Date of test .....

12. **Tunnel:** Type of lining .....

Dimensions: ..... (Length, course, and cross sectional size)

Position of water bearing stratum with reference to portal of tunnel .....

Log of tunnel: (Preceding table for log of well may be used, if desired. Give footage from portal and character of materials, as pertinent.)

13. **Pumping Equipment:**

(a) Pump BERKLEY #203 LL, 6 STAGE TURBIN (Make, type and size) Capacity 350 g.p.m.

(b) Motor TYPE U.S. MOTOR, 10 HORSEPOWER (Type and horsepower)

14. Location of area irrigated or to be irrigated, or place of use if for purposes other than irrigation.

Township North or South	Range E. or W. of Willamette Meridian	Section	Forty-acre Tract	Number Acres To Be Irrigated	Date of Reclamation
5S	1W	4	SW1/4 SE1/4	13	Aug. 11, 1950
5S	1W	4	SE1/4 SW1/4	23	Aug. 11, 1950
5S	1W	4	SW1/4 SW1/4	2	Aug. 11, 1950
			TOTAL	38 ACRES.	

15. If the ground water supply is supplemental to an existing water supply, identification of any application for a permit, permit, certificate or adjudicated right to appropriate water made or held by the registrant.

.....

.....

Township 56 Range 1 W, W.M.

North

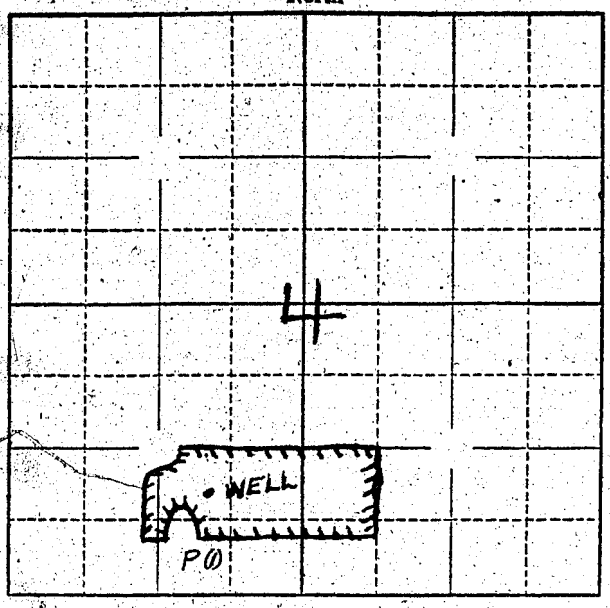

Locate well and acreage of irrigated land on plat.

Scale: 4" = 1 Mile

STATE OF OREGON }
County of Marion } ss.

I, Warren L. Callaway, being first duly sworn, do hereby certify that I have read the foregoing Registration Statement and that all of the items therein contained are true to the best of my knowledge and belief.

Warren L. Callaway
(Signature of Registrant)

Subscribed and sworn to before me this 20 day of September, 19 57

My commission expires June 12, 1958

W E [illegible] Dunn
(Notary Public)

(SEAL)

CERTIFICATE OF REGISTRATION

STATE OF OREGON }
County of Marion } ss.

This is to certify that the foregoing Registration Statement was received in the office of the State Engineer on the 23rd day of September, 19 57, at 8:00 o'clock A. M. and has been duly recorded in said office in Book No. 4 of Registration Statements on page GR-591 C.

Witness my hand this 16th day of October, 19 57.

Lewis A. Stanley
(State Engineer)

$16.20

By
(Deputy)

GR-591 C