

Registration Statement

CERTIFICATE NO. GR-593

OF CLAIMANT OF RIGHT TO APPROPRIATE GROUND WATER

(Under Chapter 708, Oregon Laws 1955.)

TO THE STATE ENGINEER OF OREGON:

I, Henry G. Roza and Laura Romain Roza
of Rte. 1, Bx 11, Scappoose County of Columbia

State of Oregon, do hereby make application for a certificate of registration as evidence of a right to appropriate ground water.

1. Source from which water is withdrawn is pump well
(Flowing well, pump well, infiltration trench, or tunnel)

2. Location is: about 3/4 mile South of Scappoose on old Portland highway;
(Approximate distance and direction from nearest city or town)

and is more particularly described as follows:

(a) 1870 feet south and 2500 feet east from the NW corner of section 13
(Give distance and bearing to corner of section or other legal subdivision)

being within SE 1/4 of NW 1/4 of Sec. 13, Twp. 3 N, Rge. 2 W
(Smallest legal subdivision) (N. or S.) (E. or W.)

or (b) within limits of recorded platted property, town or city:

in Lot _____, Block _____ of _____
(Name of plat or addition)

County of _____
(If within city or town, give name)

3. Construction Work was begun on March 15, 1946; was completed on August 16, 1946
(Date) (Date)

and the ground water claimed was first used for the purposes set out below on August 26, 1946
(Date)

since which time the water has been used continuously
(Continuously or intermittently)

from August 26, 1946 to October 31, 1956
(Date) (Date)

4. Quantity of water claimed and used is 20 gallons gallons per minute; two acre feet per year.

5. Purpose or Purposes for which water is used domestic, stock water, and irrigation

(Domestic, irrigation, municipal, manufacturing, industrial, etc.)

6. Description of Well: Depth 133 feet. Type drilled
(Dug or drilled)

diameter six inches. Elevation of ground at well site 45 62 feet, 62 on level.
(As near as known)

Depth to water table 40 feet.

7. Capacity of Well: _____ g.p.m. with _____ feet drawdown.

_____ g.p.m. with _____ feet drawdown.

Date of test _____ well not tested and capacity not known.

If Flowing Well: Measured discharge _____ g.p.m. on _____
(Date)

Shut-in pressure at ground surface _____ lbs. per sq. in. on _____
(Date)

Water is controlled by _____
(Cap, valve, etc.)

8. Casing: (Give diameter, commercial specifications and depth below ground surface of each casing size.)

6 inch diameter from ground level to 133 feet
 inch diameter from to feet
 inch diameter from to feet
 inch diameter from to feet

Describe and show depth of shoe, plug, adapter, liner or other details:

9. Perforated Casings or Screens:

none from to
 (Number per foot and size of perforations, or describe screen)
 from to
 from to
 from to

10. Log of Well: (Describe each stratum or formation clearly, indicate if water bearing, and give thickness and depth as indicated.)

MATERIAL	Thickness (Feet)	Depth to Bottom (Feet)
Soil mixed with gravel	40	40
Sand	81	121
Clay	6	127
gravel	6	133

This well is located about 125 feet from the front line (highway) and 90 feet from the south line of this property described as follows: Beginning at a stone in the center of the county road which is south 16° 34' 7.03 chains west from the northeast corner of that certain tract of land conveyed by Mary J. Tompkins, a widow, to Wilhelm Metz by deed recorded July 8, 1905 in book 5, page 143; deed records of said Columbia county; running thence south 16° 34' West a distance of 272 feet to a stone in the center of said county road; thence north 89° 07' West to the center of South Scappoose Creek; Thence down the center of said creek to a point which is north 89° 07' West of the point of beginning and thence south 89° 07' East to the point of beginning, containing 9.5 Acres, all being in Section 13, Township 3 North, of Range 2 West of the Willamette Meridian, Columbia county, State of Oregon

GR-593
 GR-593 A

If log of well is not available, give name and address of driller..... Drilled by owner.....

11. Infiltration Trench: Covered or open.....

Dimensions: Length..... ft. Minimum depth..... ft. Maximum depth..... ft.

Bottom width..... ft. Discharge..... g.p.m. Date of test.....

12. Tunnel: Type of lining.....

Dimensions:.....
(Length, course, and cross sectional size)

Position of water bearing stratum with reference to portal of tunnel.....

Log of tunnel: (Preceding table for log of well may be used, if desired. Give footage from portal and character of materials, as pertinent.)

13. Pumping Equipment:

(a) Pump Berkeley Jet 3 horse Capacity 20 g.p.m.
(Make, type and size)


(b) Motor General Electric Tri-Clad 3 horse
(Type and horsepower)

14. Location of area irrigated or to be irrigated, or place of use if for purposes other than irrigation.

Township North or South	Range E. or W. of Willamette Meridian	Section	Forty-acre Tract	Number Acres To Be Irrigated	Date of Reclamation
3 N	2 W	13	SE $\frac{1}{4}$ NW $\frac{1}{4}$	3	Prior to 1905

15. If the ground water supply is supplemental to an existing water supply, identification of any application for a permit, permit, certificate or adjudicated right to appropriate water made or held by the registrant.

Township 3 N Range 2 W, W.M.
North

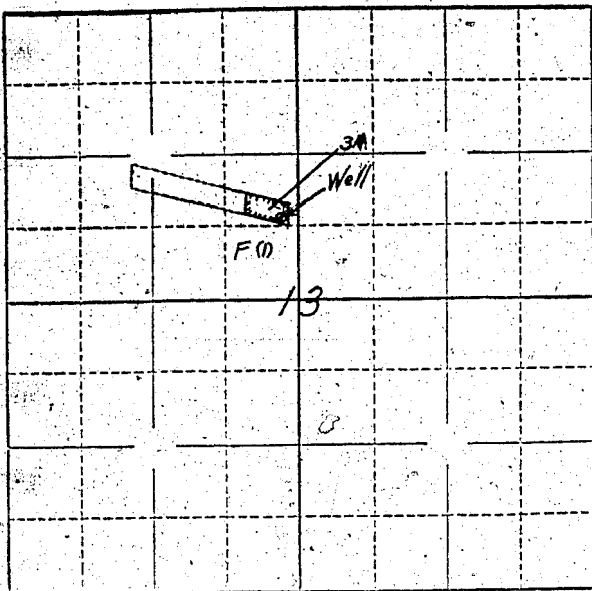

Locate well and acreage of irrigated land on plat.

Scale: $\frac{1}{4}$ " = 1 Mile

STATE OF OREGON

County of Columbia

ss.

I, Henry G. Roza, being first duly sworn, do hereby certify that I have read the foregoing Registration Statement and that all of the items therein contained are true to the best of my knowledge and belief.

Henry G. Roza
(Signature of Registrant)

Subscribed and sworn to before me this 17th day of June, 1957

My commission expires

J. J. Kearns
(Notary Public)

(SEAL)

M.V. 413 600

CERTIFICATE OF REGISTRATION

STATE OF OREGON

County of Marion

ss.

This is to certify that the foregoing Registration Statement was received in the office of the State Engineer on the 24th day of September, 1957, at 8:00 o'clock A. M. and has been duly recorded in said office in Book No. 4 of Registration Statements on page GR-593 C.

~~Construction shall be completed by~~ ~~XXXXXX~~ ~~and the water completely applied to~~ ~~beneficial use by~~ ~~XXXXXX~~

Witness my hand this 16th day of October, 1957

Leura A. Stanley
(State Engineer)

By _____ (Deputy)

GR-593C

#15.00