

Well No. 2

1955  
STATE ENGINEER

REGISTRATION NO. GR-63

CERTIFICATE NO. GR-54

# Registration Statement

## OF CLAIMANT OF RIGHT TO APPROPRIATE GROUND WATER

(Under Chapter 708, Oregon Laws 1955.)

TO THE STATE ENGINEER OF OREGON: #1

I, The City of Newberg, a municipal corporation  
of Yamhill County of Yamhill  
State of Oregon, does hereby make application for a certificate of registration as evidence of a right to appropriate ground water.

1. Source from which water is withdrawn is pump well  
(Flowing well, pump well, infiltration trench, or tunnel)

2. Location is: approximately two miles south of the Newberg City Hall in Marion County, Oregon. (Approximate distance and direction from nearest city or town)  
and is more particularly described as follows: situated.

(a) 1300 feet east and 502 feet south of the quarter corner between  
(Give distance and bearing to corner of section or other legal subdivision)

being within Sec. 28 and 30 in Twp. 3 South, Rge. 2 West  
(Smallest legal subdivision) (N. or S.) (E. or W.)

or (b) within limits of recorded platted property, town or city: Not applicable.

in Lot \_\_\_\_\_, Block \_\_\_\_\_ of \_\_\_\_\_  
(Name of plat or addition)

County of \_\_\_\_\_  
(If within city or town, give name)

3. Construction Work was begun on September, 1951; was completed on October, 1951  
(Date) (Date)

and the ground water claimed was first used for the purposes set out below on July, 1952  
(Date)

since which time the water has been used intermittently  
(Continuously or intermittently)

from July, 1952 to present time  
(Date) (Date)

4. Quantity of water claimed and used is 1000 gallons per minute; \_\_\_\_\_ acre feet per year.

5. Purpose or Purposes for which water is used municipal

(Domestic, irrigation, municipal, manufacturing, industrial, etc.)

6. Description of Well: Depth 90 feet. Type drilled  
(Dug or drilled)

diameter 12 inches. Elevation of ground at well site approx. 1100 feet, mean sea level.  
(As near as known)

Depth to water table 35 feet.

7. Capacity of Well: 1500 g.p.m. with no feet drawdown.

----- g.p.m. with ----- feet drawdown.

Date of test 1951

If Flowing Well: Measured discharge \_\_\_\_\_ g.p.m. on \_\_\_\_\_  
(Date)

Shut-in pressure at ground surface \_\_\_\_\_ lbs. per sq. in. on \_\_\_\_\_  
(Date)

Water is controlled by \_\_\_\_\_  
(Cap, valve, etc.)

8. Casing: (Give diameter, commercial specifications and depth below ground surface of each casing size.)

12 inch diameter from top to bottom feet  
 inch diameter from to feet  
 inch diameter from to feet  
 inch diameter from to feet

Describe and show depth of shoe, plug, adapter, liner or other details:

9. Perforated Casings or Screens:

Perforations approx. 1 1/4" x 3", approx. 6 ft. of perforated casing.  
 (Number per foot and size of perforations, or describe screen)

from to  
 from to  
 from to

10. Log of Well: (Describe each stratum or formation clearly, indicate if water bearing, and give thickness and depth as indicated.)

| MATERIAL  | Thickness (Feet) | Depth to Bottom (Feet) |
|---|------------------|------------------------|
| Black dirt  | 44               | 44                     |
| Sand and scattered gravel (heaved like quicksand) | 15               | 59                     |
| Sand, gravel and wood                             | 4                | 63                     |
| Blue sand and gravel                              | 14               | 77                     |
| Large gravel (much water)                         | 11               | 88                     |
| Sand (no water)                                   | 2                | 90                     |
|   |                  |                        |
|   |                  |                        |
If log of well is not available, give name and address of driller. ....

11. Infiltration Trench: Covered or open Not applicable.

Dimensions: Length ..... ft. Minimum depth ..... ft. Maximum depth ..... ft.

Bottom width ..... ft. Discharge ..... g.p.m. Date of test .....

12. Tunnel: Type of lining Not applicable.

Dimensions: .....  
(Length, course, and cross sectional size)

Position of water bearing stratum with reference to portal of tunnel .....

Log of tunnel: (Preceding table for log of well may be used, if desired. Give footage from portal and character of materials, as pertinent.)

13. Pumping Equipment:

(a) Pump Syron Jackson, submersible, 8 inch. Capacity approx. 750 g.p.m.  
(Make, type and size)


(b) Motor Electric, 3 phase, 40 H.P.  
(Type and horsepower)

14. Location of area irrigated or to be irrigated, or place of use if for purposes other than irrigation.

| Township<br>North or South | Range<br>E. or W. of<br>Williamette<br>Meridian | Section            | MUNICIPALITY:            | Number acres &<br>Acres irrigated | TYPE OF<br>IRRIGATION |
|----------------------------|---|--------------------|--------------------------|-----------------------------------|-----------------------|
| T 3 S.                     | R. 2 W.   | 17, 18,<br>19 & 20 | City of Newberg, Oregon, |                                   | municipal use.        |
|                            |   |                    |                          |                                   |                       |
|                            |   |                    |                          |                                   |                       |
15. If the ground water supply is supplemental to an existing water supply, identification of any application for a permit, permit, certificate or adjudicated right to appropriate water made or held by the registrant. Supplemental to existing water rights held by City of Newberg in various springs outside the city limits on the north and northeast. See records of State Engineer.

Township 3 South Range 2 West, W.M.  
North

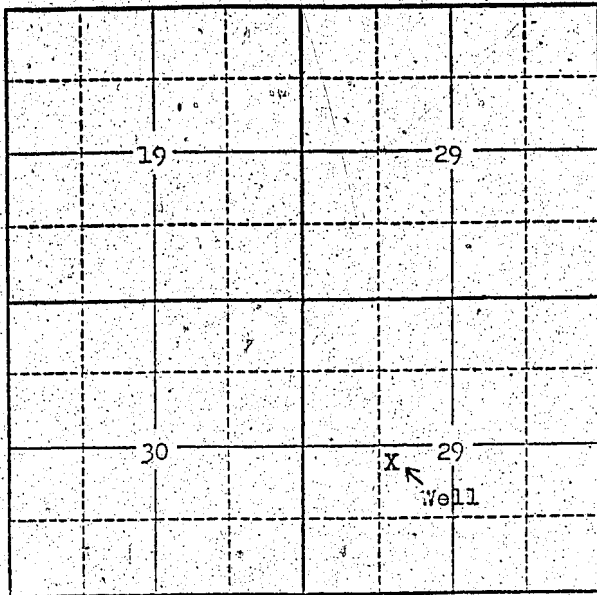

Locate well and acreage of irrigated land on plat.  
Scale: 2" = 1 Mile

STATE OF OREGON

County of Washill } ss.

I, Weller Probasco, being first duly sworn, do hereby certify that I have read the foregoing Registration Statement and that all of the items therein contained are true to the best of my knowledge and belief.

Weller Probasco  
(Signature of Registrant)

Subscribed and sworn to before me this 5<sup>th</sup> day of December, 1955

My commission expires 11-15-57.

Robert Miff  
(Notary Public) for Oregon

(SEAL)

**CERTIFICATE OF REGISTRATION**

STATE OF OREGON

County of Marion } ss.

*For Registration Certificate see page GR-54 G*

This is to certify that the foregoing Registration Statement was received in the office of the State Engineer on the 7<sup>th</sup> day of December, 1955, at 8:00 o'clock A. M. and has been duly recorded in said office in Book No. 1 of Registration Statements on page \_\_\_\_\_

Construction shall be completed by \_\_\_\_\_, 1955, and the water completely applied to beneficial use by \_\_\_\_\_, 1955.

Witness my hand this \_\_\_\_\_ day of \_\_\_\_\_, 1955

Lewis A. Stanley  
(State Engineer)

By \_\_\_\_\_ (Deputy)

Well No. 2

# Registration Statement

## OF CLAIMANT OF RIGHT TO APPROPRIATE GROUND WATER

(Under Chapter 703, Oregon Laws 1955.)

TO THE STATE ENGINEER OF OREGON:

42

I, The City of Newberg, a municipal corporation  
of \_\_\_\_\_ County of Yamhill

State of Oregon, does hereby make application for a certificate of registration as evidence of a right to appropriate ground water.

1. Source from which water is withdrawn is pump well  
(Flowing well, pump well, infiltration trench, or tunnel)

2. Location is: approximately two miles south of the Newberg City Hall  
(Approximate distance and direction from nearest city or town)  
in Marion County, Oregon. Within the acre tract in which Well No. 2 and is more particularly described as follows: is situated.

(a) 1300 feet east and 502 feet south of the quarter corner between  
(Give distance and bearing to corner of section or other legal subdivision)  
being within Sec. 29 and 30 in 702 of Sec. 29, Twp. 3 South Rge. 2 West. W.M.  
(Smallest legal subdivision) (N. or S.) (E. or W.)

or (b) within limits of recorded platted property, town or city: Not applicable.  
in Lot \_\_\_\_\_, Block \_\_\_\_\_ of \_\_\_\_\_  
(Name of plat or addition)

County of \_\_\_\_\_  
(If within city or town, give name)

3. Construction Work was begun on May, 1948; was completed on December, 1948  
(Date) (Date)

and the ground water claimed was first used for the purposes set out below on July, 1949  
(Date)

since which time the water has been used intermittently  
(Continuously or intermittently)

from July, 1949 to present time  
(Date) (Date)

4. Quantity of water claimed and used is 1000 gallons per minute; \_\_\_\_\_ acre  
feet per year.

5. Purpose or Purposes for which water is used municipal  
(Domestic, irrigation, municipal, manufacturing, industrial, etc.)

6. Description of Well: Depth 90 feet. Type drilled  
(Dug or drilled)  
diameter 12 inches. Elevation of ground at well site APPROX. 100 feet, mean sea level.  
(As near as known)  
Depth to water table 35 feet.

7. Capacity of Well: 1500 g.p.m. with no feet drawdown.  
\_\_\_\_\_ g.p.m. with \_\_\_\_\_ feet drawdown.

Date of test 1948

If Flowing Well: Measured discharge \_\_\_\_\_ g.p.m. on \_\_\_\_\_  
(Date)

Shut-in pressure at ground surface \_\_\_\_\_ lbs. per sq. in. on \_\_\_\_\_  
(Date)

Water is controlled by \_\_\_\_\_  
(Cap, valve, etc.)

8. Casing: (Give diameter, commercial specifications and depth below ground surface of each casing size.)

12 inch diameter ..... from top to bottom: feet  
 ..... inch diameter ..... from ..... to ..... feet  
 ..... inch diameter ..... from ..... to ..... feet  
 ..... inch diameter ..... from ..... to ..... feet

Describe and show depth of shoe, plug, adapter, liner or other details: .....

9. Perforated Casings or Screens:

Perforations approx. 1 1/2" x 3"; approx. 6 ft. of perforated casing.  
(Number per foot and size of perforations, or describe screen)  
 ..... from ..... to .....  
 ..... from ..... to .....  
 ..... from ..... to .....

10. Log of Well: (Describe each stratum or formation clearly, indicate if water bearing, and give thickness and depth as indicated.)

| MATERIAL  | Thickness (Feet) | Depth to Bottom (Feet) |
|---|------------------|------------------------|
| Black dirt  | 14               | 14                     |
| Sand and scattered gravel (heaved like quicksand) | 15               | 59                     |
| Sand, gravel and wood                             | 4                | 63                     |
| Blue sand and gravel                              | 14               | 77                     |
| Large gravel (much water)                         | 11               | 88                     |
| Sand (no water)                                   | 2                | 90                     |
|   |                  |                        |
|   |                  |                        |
If log of well is not available, give name and address of driller: .....

11. Infiltration Trench: Covered or open Not applicable.

Dimensions: Length ..... ft. Minimum depth ..... ft. Maximum depth ..... ft.

Bottom width ..... ft. Discharge ..... g.p.m. Date of test .....

12. Tunnel: Type of lining Not applicable.

Dimensions: .....  
(Length, course, and cross sectional size)

Position of water bearing stratum with reference to portal of tunnel: .....

Log of tunnel: (Preceding table for log of well may be used, if desired. Give footage from portal and character of materials, as pertinent.)

13. Pumping Equipment:

(a) Pump Eyrton Jackson, submersible, 8 inch. Capacity approx. 750 g.p.m.  
(Make, type and size)

(b) Motor Electric, 3 phase, 40 H.P.  
(Type and horsepower)


14. Location of area irrigated or to be irrigated, or place of use if for purposes other than irrigation.

| Township North or South | Range E. or W. of Willamette Meridian | Section         | APPROXIMATE                             | APPROXIMATE TO EACH SECTION | TYPE OF RECLAMATION |
|-------------------------|---------------------------------------|-----------------|---|-----------------------------|---------------------|
| T. 3 S.                 | R. 2 W.                               | 17, 18, 19 & 20 | City of Newberg, Oregon, municipal use. |                             |                     |
|                         |                                       |                 |   |                             |                     |
|                         |                                       |                 |   |                             |                     |
15. If the ground water supply is supplemental to an existing water supply, identification of any application for a permit, permit, certificate or adjudicated right to appropriate water made or held by the registrant.

Supplemental to existing water rights held by City of Newberg in various springs outside the city limits on the north and northeast. See records of State Engineer.

Township 3 South Range 2 West W.M.  
North

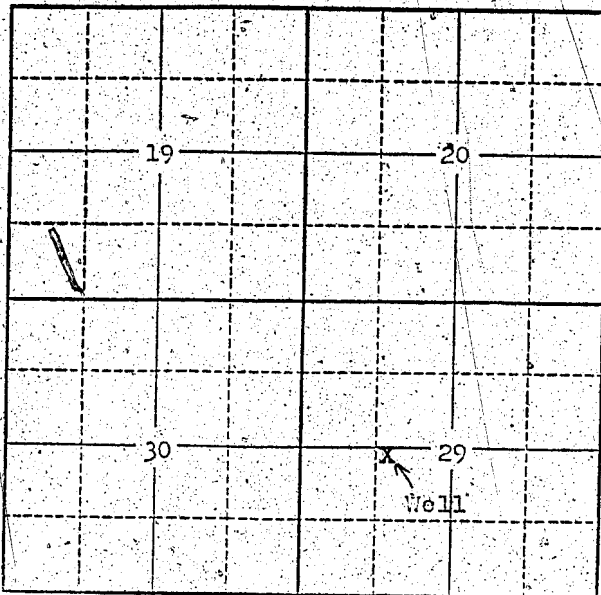

Locate well and acreage of irrigated land on plat.

Scale: 2" = 1 Mile

STATE OF OREGON

County of Wamhill } ss.

I, Weller Probasco, being first duly sworn, do hereby certify that I have read the foregoing Registration Statement and that all of the items therein contained are true to the best of my knowledge and belief.

Weller Probasco  
(Signature of Registrant)

Subscribed and sworn to before me this 5th day of December, 1955

My commission expires 11-15-57.  
Herbert Jiff  
(Notary Public) for Oregon

(SEAL)

**CERTIFICATE OF REGISTRATION**

STATE OF OREGON }  
County of Marion } ss.

This is to certify that the foregoing Registration Statement was received in the office of the State Engineer on the 7th day of December, 1955, at 8:00 o'clock A. M. and has been duly recorded in said office in Book No. 1 of Registration Statements on page 54.

Construction shall be completed by \_\_\_\_\_, 19\_\_\_\_, and the water completely applied to beneficial use by \_\_\_\_\_, 19\_\_\_\_.

Witness my hand this 24th day of February, 1956.

Lewis A. Stanley  
(State Engineer)

By \_\_\_\_\_  
(Deputy)