

Registration Statement

OF CLAIMANT OF RIGHT TO APPROPRIATE GROUND WATER

TO THE STATE ENGINEER OF OREGON:

I, MRS. ALICE M. BEARDSLEYof 5040 HERRIN ROAD County of MARION
(Mailing address)State of OREGON, do hereby make application for a certificate of registration as evidence of a right to appropriate ground water.1. Source from which water is withdrawn is PUMP WELL
(Flowing well, pump well, infiltration trench, or tunnel)2. Location is: 5 1/2 MILES N.E. OF SALEM
(Approximate distance and direction from nearest city or town)

and is more particularly described as follows:

(a) Page 2400 ft. North and 200 feet West of S 1/4 corner.
Vol 259-286
From N.E. corner 1738 Ft. due West, Then 266 Ft. 10 in. due South to Well
(Give distance and bearing to corner of section or other legal subdivision)being within NE 1/4 of Sec. 8 of Sec. 8, Twp. 7S, Rge. B2W
(Smallest legal subdivision) (N. or S.) (E. or W.)

or (b) within limits of recorded platted property, town or city:

in Lot _____, Block _____ of _____
(Name of plat or addition)(If within city or town, give name) County of Marion3. Construction Work was begun on March 1952 was completed on March 1952
(Date) (Date)and the ground water claimed was first used for the purposes set out below on May 1952
(Date)since which time the water has been used Continuously
(Continuously or Intermittently)from May 1952 to Sept 1957
(Date) (Date)4. Quantity of water claimed and used is 240 gallons per minute; _____ acre feet per year.5. Purpose or Purposes for which water is used Irrigation (crops)

(Domestic, irrigation, municipal, manufacturing, industrial, etc.)

6. Description of Well: Depth 116 feet. Type Drilled
(Dug or drilled)diameter 8 1/2 inches. Elevation of ground at well site 180 feet feet, mean sea level.
(As near as known)

Depth to water table _____ feet.

7. Capacity of Well: 240 g.p.m. with _____ feet drawdown.

_____ g.p.m. with _____ feet drawdown.

Date of test _____

If Flowing Well: Measured discharge _____ g.p.m. on _____
(Date)Shut-in pressure at ground surface _____ lbs. per sq. in. on _____
(Date)Water is controlled by _____
(Cap, valve, etc.)

size.

size.) $5\frac{1}{4}$ O.D. at $7\frac{7}{8}$ I.D.
inch diameter

inch diameter

inch diameter

inch diameter

Describe and show depth of shoe, plug, adapter, liner or other details

Describe and show depth of shoe, plug, adapter, liner or other details: Shoe welded
on bottom of casing.

9. Perforated Casings or Screens:

9. Perforated Casings or Screens: *Mills Perforator*
9 perforations per ft 6 rows from *104'* to *116'*
 (Number per foot and size of perforations, or describe screen)

(Number per foot and size of perforations, or describe screen)

Size of holes $3/16 \times 2"$ from to

from to

from to

10. **Log of Well:** (Describe each stratum or formation clearly, indicate if water bearing, and give thickness and depth as indicated.)

[illegible]

If log of well is not available, give name and address of driller.

11. Infiltration Trench: Covered or open

Dimensions: Length ft. Minimum depth ft. Maximum depth ft.

Bottom width ft. Discharge g.p.m. Date of test :

12. Tunnel: Type of lining _____

Dimensions:

(Length, course, and cross sectional size)

Position of water bearing stratum with reference to portal of tunnel

Log of tunnel: (Preceding table for log of well may be used, if desired. Give footage from portal and character of materials, as pertinent.)

- ### 13. Pumping Equipment:

(a) Pump BERTERLEY Turbine Capacity 180 g.p.m.

(Make, type and size)

(b) Motor ELECTRIC 15 HP


(Type and horsepower)

14. Location of area irrigated or to be irrigated, or place of use if for purposes other than irrigation.

[illegible]

15. If the ground water supply is supplemental to an existing water supply, identification of any application for a permit, permit, certificate or adjudicated right to appropriate water made or held by the registrant.

Sec 8 Township 75 Range 2 W., W.M.
North

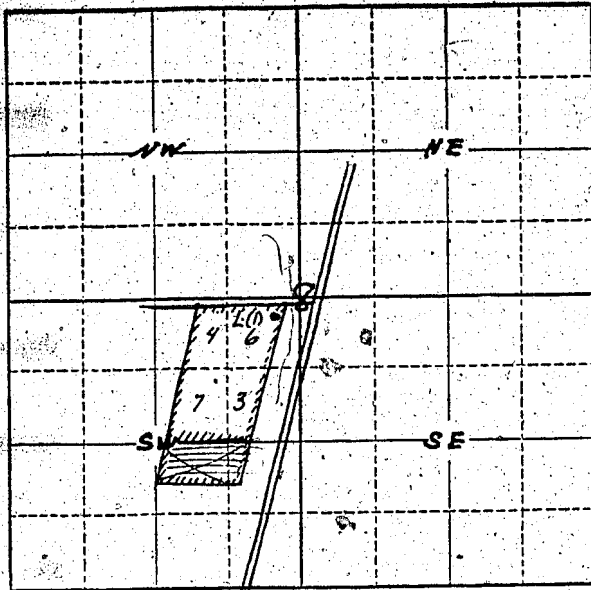

Locate well and acreage of irrigated land on plat.

Scale: $\frac{1}{4}$ " = 1 Mile

STATE OF OREGON

County of Marion } ss.

I, Alice M. Beardsley, being first duly sworn, do hereby certify that I have read the foregoing Registration Statement and that all of the items therein contained are true to the best of my knowledge and belief.

Alice M. Beardsley
(Signature of Registrant)

Subscribed and sworn to before me this 26th day of September, 1957

My commission expires June 12th 1961

Wm. S. Bartholomew
(Notary Public)

(SEAL)

CERTIFICATE OF REGISTRATION

STATE OF OREGON

County of Marion } ss.

This is to certify that the foregoing Registration Statement was received in the office of the State Engineer on the 26th day of September, 1957, at 11:30 o'clock A.M. and has been duly recorded in said office in Book No. 4 of Registration Statements on page GR-596 C

Witness my hand this 16th day of October, 1957

Lewis A. Stanley
(State Engineer)

By

(Deputy)

GR - 596 C