Registration No. GR-635

Certificate No. GR-600

Registration Statement

OF CLAIMANT OF RIGHT TO APPROPRIATE GROUND WATER

TO THE STATE ENGINEER OF OREGON:

I, Milo Jensen and Ida B. Jensen,

of Route # 1 Box 343 A, Independence, Oregon (Mailing address) County of Polk

State of Oregon, do hereby make application for a certificate of registration as evidence of a right to appropriate ground water.

1. **Source** from which water is withdrawn is Pump well (Flowing well, pump well, infiltration trench, or tunnel)

2. **Location is:** One and 3/4 miles North of Monmouth, Oregon (Approximate distance and direction from nearest city or town);

and is more particularly described as follows:

(a) 450 feet west and 200 feet north from E¼ corner of section 13. ~~About the center of Twp. 8 South Range 5 West, W.M.~~ (Give distance and bearing to corner of section or other legal subdivision)

being within M D Sturgess (Smallest legal subdivision) of Sec. 13, Twp. 8 S (N. or S.), Rge. 5 W (E. or W.)

or (b) within limits of recorded platted property, town or city:

in Lot ....., Block ..... of ..... (Name of plat or addition)

..... (If within city or town, give name) County of Polk

3. **Construction Work** was begun on July 1951 (Date); was completed on July 1951 (Date)

and the ground water claimed was first used for the purposes set out below on July 1951 (Date),

since which time the water has been used intermittently (Continuously or intermittently)

from June (Date) to October (Date)

4. **Quantity** of water claimed and used is 4 gallons per minute; ..... acre feet per year.

5. **Purpose or Purposes** for which water is used irrigating pasture and hay land (Domestic, irrigation, municipal, manufacturing, industrial, etc.)

6. **Description of Well:** Depth 98 feet. Type drilled (Dug or drilled)

diameter 8 inches. Elevation of ground at well site 192 ~~[illegible]~~ (As near as known) feet, mean sea level.

Depth to water table 90 feet.

7. **Capacity of Well:** 40 g.p.m. with 62 feet drawdown.

..... g.p.m. with ..... feet drawdown.

Date of test July 1957

If Flowing Well: Measured discharge ..... g.p.m. on ..... (Date)

Shut-in pressure at ground surface ..... lbs. per sq. in. on ..... (Date)

Water is controlled by ..... (Cap, valve, etc.)

4M—4-57

8. **Casing:** (Give diameter, commercial specifications and depth below ground surface of each casing size.)

8 inch diameter from 8 to 98 feet

..... inch diameter from ..... to ..... feet

..... inch diameter from ..... to ..... feet

..... inch diameter from ..... to ..... feet

Describe and show depth of shoe, plug, adapter, liner or other details: .....

9. **Perforated Casings or Screens:**

not known from ..... to .....
(Number per foot and size of perforations, or describe screen)

..... from ..... to .....

..... from ..... to .....

..... from ..... to .....

10. **Log of Well:** (Describe each stratum or formation clearly, indicate if water bearing, and give thickness and depth as indicated.)

MATERIAL	Thickness (Feet)	Depth to Bottom (Feet)
Not known		

GR-600 A

If log of well is not available, give name and address of driller. Marion West, Salem, Oregon

11. **Infiltration Trench:** Covered or open none

Dimensions: Length ..... ft. Minimum depth ..... ft. Maximum depth ..... ft.

Bottom width ..... ft. Discharge ..... g.p.m. Date of test .....

12. **Tunnel:** Type of lining .....

Dimensions: .....
(Length, course, and cross sectional size)

Position of water bearing stratum with reference to portal of tunnel .....

Log of tunnel: (Preceding table for log of well may be used, if desired. Give footage from portal and character of materials, as pertinent.)

13. **Pumping Equipment:**

(a) Pump Jacuzzi 15 URG80 (Make, type and size) Capacity 40 g.p.m.

(b) Motor Robbins & Myers single phase 1½ HP (Type and horsepower)

14. Location of area irrigated or to be irrigated, or place of use if for purposes other than irrigation.

Township North or South	Range E. or W. of Willamette Meridian	Section	Forty-acre Tract	Number Acres To Be Irrigated	Date of Reclamation
TWP 8 S	5 W	13	SE¼ of NE¼	5	July 1951

15. If the ground water supply is supplemental to an existing water supply, identification of any application for a permit, permit, certificate or adjudicated right to appropriate water made or held by the registrant.

.....

.....

Approximately well is located 980 Northwest of Southwest corner stone marker. 240 feet North from South fence dividing line, 280 feet West to highway fence.

Township 8 S Range 5 W, W.M.

North

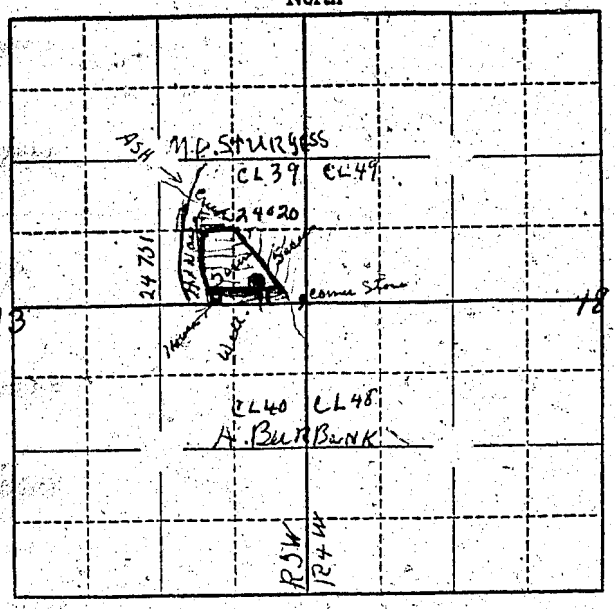

Locate well and acreage of irrigated land on plat.

Scale: 2" = 1 Mile

STATE OF OREGON

I, Milo & Ida B. Jensen, being first duly sworn, do hereby certify that I have read the foregoing Registration Statement and that all of the items therein contained are true to the best of my knowledge and belief.

x Milo Jensen
x Ida B. Jensen
(Signature of Registrant)

Subscribed and sworn to before me this 12th day of September, 1957

My commission expires MY COMMISSION EXPIRES OCT. 7, 1957

(Notary Public)

(SEAL)

CERTIFICATE OF REGISTRATION

STATE OF OREGON
County of Marion } ss.

This is to certify that the foregoing Registration Statement was received in the office of the State Engineer on the 1st day of October, 1957 at 8:00 o'clock A. M. and has been duly recorded in said office in Book No. 4 of Registration Statements on page GR-600 C

Witness my hand this 16th day of October, 1957

Lewis A. Stanley
(State Engineer)

By
(Deputy)

#1500

GR - 600 C