

Registration No. GR. 645

Certificate No. GR. 610

# Registration Statement

## OF CLAIMANT OF RIGHT TO APPROPRIATE GROUND WATER

TO THE STATE ENGINEER OF OREGON:

I, Aden A. Chambers

of Rt. 2, Box 322, Albany County of Linn

State of Oregon, do hereby make application for a certificate of registration as evidence of a right to appropriate ground water.

1. Source from which water is withdrawn is Pump well No. 1  
(Flowing well, pump well, infiltration trench, or tunnel)

2. Location is: 9 1/2 miles N. of Albany, Oregon  
(Approximate distance and direction from nearest city or town)

and is more particularly described as follows:

(a) S. 67 1/2° W. 26.75 chains from the most Nly. N.W. Cor. DLC 38  
(Give distance and bearing to corner of section or other legal subdivision)

being within SE 1/4 of NE 1/4 of Sec. 11, Twp. 10 S, Rge. 4 W.  
(Smallest legal subdivision) (N. or S.) (E. or W.)

or (b) within limits of recorded platted property, town or city:

in Lot \_\_\_\_\_, Block \_\_\_\_\_ of \_\_\_\_\_  
(Name of plat or addition)  
County of Linn  
(If within city or town, give name)

3. Construction Work was begun on May, 1944; was completed on May, 1944  
(Date) (Date)

and the ground water claimed was first used for the purposes set out below on June, 1944  
(Date)

since which time the water has been used continuously  
(Continuously or Intermittently)

from June, 1944 to present time  
(Date) (Date)

4. Quantity of water claimed and used is 330 gallons per minute; 68.75 acre feet per year.

5. Purpose or Purposes for which water is used Irrigation  
(Domestic, irrigation, municipal, manufacturing, industrial, etc.)

6. Description of Well: Depth 26 feet. Type Drilled  
(Dug or drilled)

diameter 12 inches. Elevation of ground at well site 172 feet, mean sea level  
(As near as known)

Depth to water table 12 feet.

7. Capacity of Well: 400 g.p.m. with 5 feet drawdown.

\_\_\_\_\_ g.p.m. with \_\_\_\_\_ feet drawdown.

Date of test Not tested - estimated

If Flowing Well: Measured discharge \_\_\_\_\_ g.p.m. on \_\_\_\_\_  
(Date)


Shut-in pressure at ground surface \_\_\_\_\_ lbs. per sq. in. on \_\_\_\_\_  
(Date)

Water is controlled by \_\_\_\_\_  
(Cap, valve, etc.)





Township 10 S Range 4 W., W.M.  
North

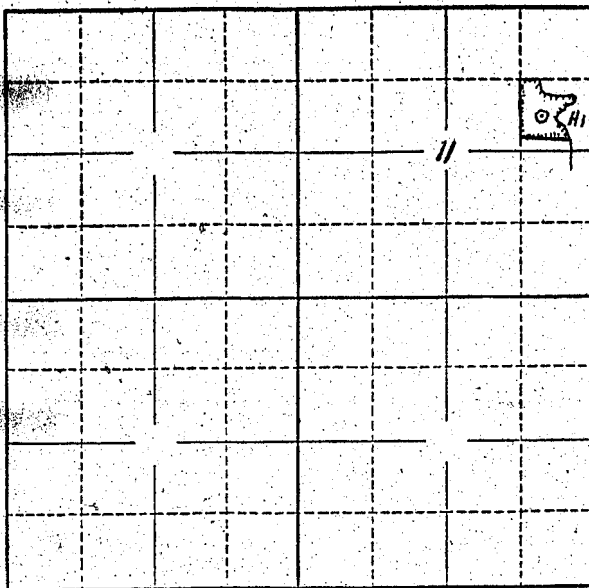

Locate well and acreage of irrigated land on plat.  
Scale: 2" = 1 Mile

STATE OF OREGON

County of Linn } ss.

I, Aden A. Chambers, being first duly sworn, do hereby certify that I have read the foregoing Registration Statement and that all of the items therein contained are true to the best of my knowledge and belief.

*Aden A. Chambers*  
(Signature of Registrant)

Subscribed and sworn to before me this 21th day of September, 1957.

My commission expires 7-23-60

*Rudh Skinner*  
(Notary Public)

(SEAL)

CERTIFICATE OF REGISTRATION

STATE OF OREGON

County of Marion } ss.

This is to certify that the foregoing Registration Statement was received in the office of the State Engineer on the 4th day of October, 1957, at 8:00 o'clock A.M. and has been duly recorded in said office in Book No. 4 of Registration Statements on page GR-610 C.

Witness my hand this 16th day of October, 1957.

*Lewis A. Stanley*  
(State Engineer)

\$15.00

By \_\_\_\_\_ (Deputy)