

Registration Statement CERTIFICATE NO. GR 614

OF CLAIMANT OF RIGHT TO APPROPRIATE GROUND WATER

(Under Chapter 708, Oregon Laws 1955.)

TO THE STATE ENGINEER OF OREGON:

I, John G. Graham

of Route 3, Box 555, Corvallis County of Benton

State of Oregon, do hereby make application for a certificate of registration as evidence of a right to appropriate ground water.

1. Source from which water is withdrawn is pump well #1
(Flowing well, pump well, infiltration trench, or tunnel)

2. Location is: 11 miles south of Corvallis
(Approximate distance and direction from nearest city or town)

and is more particularly described as follows:

(a) 381' N 65° W from 1 1/2 x 1 1/2 angle iron located on quarter section line 880' W of center of
(Give distance and bearing to corner of section or other legal subdivision)

being within SE 1/4 of NW 1/4 of Sec. 24, Twp. 13 S, Rge. 5 W
(Smallest legal subdivision) (N. or S.) (E. or W.)

or (b) within limits of recorded platted property, town or city:

in Lot _____, Block _____ of _____
(Name of plat or addition)

County of _____
(If within city or town, give name)

3. Construction Work was begun on 1940; was completed on 1940
(Date) (Date)

and the ground water claimed was first used for the purposes set out below on 1940
(Date)

since which time the water has been used continuously
(Continuously or Intermittently)

from 1940 to 1957
(Date) (Date)

4. Quantity of water claimed and used is 650 gallons per minute; 207 acre feet per year.

5. Purpose or Purposes for which water is used irrigation

(Domestic, irrigation, municipal, manufacturing, industrial, etc.)

6. Description of Well: Depth 25 feet. Type drilled
(Dug or drilled)

diameter 6 inches. Elevation of ground at well site 242 feet, mean sea level.
(As near as known)

Depth to water table 10 feet.

7. Capacity of Well: 650 g.p.m. with 7 feet drawdown.

5 g.p.m. with _____ feet drawdown.

Date of test August, 1940

If Flowing Well: Measured discharge _____ g.p.m. on _____
(Date)

Shut-in pressure at ground surface _____ lbs. per sq. in. on _____
(Date)

Water is controlled by _____
(Cap. valve, etc.)

8. Casing: (Give diameter, commercial specifications and depth below ground surface of each casing size.)

6 inch diameter steel from surface to 25 feet
 inch diameter from to feet
 inch diameter from to feet
 inch diameter from to feet

Describe and show depth of shoe, plug, adapter, liner or other details:

9. Perforated Casings or Screens:

size and number unknown from 18' to 25'
(Number per foot and size of perforations, or describe screen)
 from to
 from to
 from to

10. Log of Well: (Describe each stratum or formation clearly, indicate if water bearing, and give thickness and depth as indicated.)

MATERIAL	Thickness (Feet)	Depth to Bottom (Feet)

If log of well is not available, give name and address of driller,

Claude Schaffer, Philomath, Oregon

11. Infiltration Trench: Covered or open

Dimensions: Length ft. Minimum depth ft. Maximum depth ft.

Bottom width ft. Discharge g.p.m. Date of test

12. Tunnel: Type of lining

Dimensions:
(Length, course, and cross sectional size)

Position of water bearing stratum with reference to portal of tunnel

Log of tunnel: (Preceding table for log of well may be used, if desired. Give footage from portal and character of materials, as pertinent.)

13. Pumping Equipment:

(a) Pump 4" centrifugal Fairbanks Capacity 650 g.p.m.
(Make, type and size)


(b) Motor JD model D tractor
(Type and horsepower)

14. Location of area irrigated or to be irrigated, or place of use if for purposes other than irrigation.

Township North or South	Range E. or W. of Willamette Meridian	Section	Forty-acre Tract	Number Acres To Be Irrigated	Date of Reclamation
13 S	5 W	24	NW ¹ / ₄ NW ¹ / ₄	15.5	1940
13 S	5 W	24	NE ¹ / ₄ NW ¹ / ₄	13.5	1940
13 S	5 W	24	SW ¹ / ₄ NW ¹ / ₄	21.5	1940
13 S	5 W	24	SE ¹ / ₄ NW ¹ / ₄	13.5	1940
13 S	5 W	24	NW ¹ / ₄ SW ¹ / ₄	15.0	1940
13 S	5 W	24	NE ¹ / ₄ SW ¹ / ₄	4.0	1940
				<u>83.0</u>	

15. If the ground water supply is supplemental to an existing water supply, identification of any application for a permit, permit, certificate or adjudicated right to appropriate water made or held by the registrant.

Township 13S Range 5W, W.M.
North

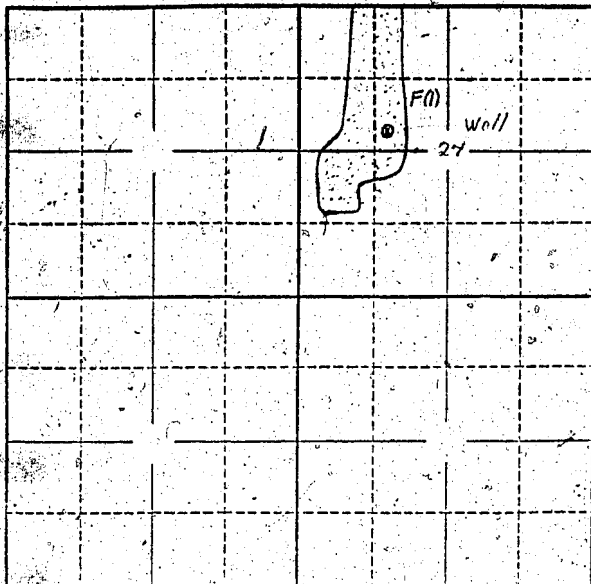

Locate well and acreage of irrigated land on plat.
Scale: 2" = 1 Mile

STATE OF OREGON

County of BENTON } ss.

I, JOHN G. GRAHAM, being first duly sworn, do hereby certify that I have read the foregoing Registration Statement and that all of the items therein contained are true to the best of my knowledge and belief.

John G. Graham
(Signature of Registrant)

Subscribed and sworn to before me this 3rd day of October, 1957

My commission expires _____
(Notary Public)

(SEAL)

CERTIFICATE OF REGISTRATION

STATE OF OREGON

County of Marion } ss.

This is to certify that the foregoing Registration Statement was received in the office of the State Engineer on the 7th day of October, 1957, at 10:00 o'clock A. M. and has been duly recorded in said office in Book No. _____ of Registration Statements on page GR-614 C.

~~Construction shall be completed by X-X-X-X-X-X-X-X-X-X, 19X-X-X and the water completely applied for beneficial use by X-X-X-X-X-X-X-X-X-X, 19X-X-X-X~~

Witness my hand this 16th day of October, 1957

Henry A. Stanley
(State Engineer)

By _____
(Deputy)

GR-614 C

22 '55