

# Registration Statement

## OF CLAIMANT OF RIGHT TO APPROPRIATE GROUND WATER

(Under Chapter 708, Oregon Laws 1955.)

TO THE STATE ENGINEER OF OREGON:

I, John G. Graham

of Route 3, Box 555, Corvallis County of Benton

State of Oregon, do hereby make application for a certificate of registration as evidence of a right to appropriate ground water.

1. Source from which water is withdrawn is drilled well #2  
(Flowing well, pump well, infiltration trench, or tunnel)

2. Location is: 11 miles south of Corvallis  
(Approximate distance and direction from nearest city or town)

and is more particularly described as follows: 902' S 50° 50' W from 1 1/2 x 1 1/2 angle iron located

(a) on quarter section line 880' W of center of  
(Give distance and bearing to corner of section or other legal subdivision)

being within (Smallest legal subdivision) of Sec. 24, Twp. 13 S, Rge. 5 W  
(N. or S.) (E. or W.)

or (b) within limits of recorded platted property, town or city:

in Lot \_\_\_\_\_, Block \_\_\_\_\_ of \_\_\_\_\_  
(Name of plat or addition)

County of \_\_\_\_\_  
(If within city or town, give name)

3. Construction Work was begun on 1911; was completed on 1911  
(Date) (Date)

and the ground water claimed was first used for the purposes set out below on 1911  
(Date)

since which time the water has been used continuously  
(Continuously or Intermittently)

from 1911 to 1957  
(Date) (Date)

4. Quantity of water claimed and used is 220 gallons per minute; 62 acre feet per year.

5. Purpose or Purposes for which water is used irrigation

(Domestic, irrigation, municipal, manufacturing, industrial, etc.)

6. Description of Well: Depth 25 feet. Type drilled  
(Dug or drilled)

diameter 6 inches. Elevation of ground at well site 245 feet, mean sea level.  
(As near as known)

Depth to water table 10 feet.

7. Capacity of Well: 220 g.p.m. with 2 feet drawdown.

0 g.p.m. with \_\_\_\_\_ feet drawdown.

Date of test 1952

If Flowing Well: Measured discharge \_\_\_\_\_ g.p.m. on \_\_\_\_\_  
(Date)


Shut-in pressure at ground surface \_\_\_\_\_ lbs. per sq. in. on \_\_\_\_\_  
(Date)

Water is controlled by \_\_\_\_\_  
(Cap, valve, etc.)





Township T. 13 S. Range R. 5 W. W.M.  
North

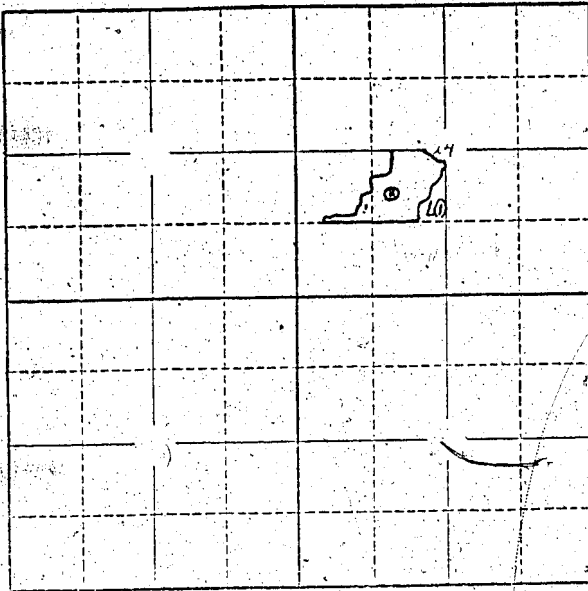

Locate well and acreage of irrigated land on plat.  
Scale: 2" = 1 Mile

STATE OF OREGON

County of Benton } ss.

I, John C. Graham, being first duly sworn, do hereby certify that I have read the foregoing Registration Statement and that all of the items therein contained are true to the best of my knowledge and belief.

John C. Graham  
(Signature of Registrant)

Subscribed and sworn to before me this 3rd day of October, 1957

My commission expires \_\_\_\_\_  
(Notary Public)

(SEAL)

**CERTIFICATE OF REGISTRATION**

STATE OF OREGON

County of Marion } ss.

This is to certify that the foregoing Registration Statement was received in the office of the State Engineer on the 7th day of October, 1957, at 10:00 o'clock A.M. and has been duly recorded in said office in Book No. 4 of Registration Statements on page GR-615 C.

Construction shall be completed by X-X-X-X-X-X-X-X-X-X-19 and the water completely applied to beneficial use by X-X-X-X-X-X-X-X-X-X-19.

Witness my hand this 16th day of October, 1957.

Lewis A. Strider  
(State Engineer)

By \_\_\_\_\_ (Deputy) GR-615 C