

# Registration Statement

## OF CLAIMANT OF RIGHT TO APPROPRIATE GROUND WATER

(Under Chapter 708, Oregon Laws 1955.)

**RECEIVED**  
NOV 18 1957

STATE ENGINEER  
OREGON

TO THE STATE ENGINEER OF OREGON:

I, Boyd Hamilton and Lucille Hamilton

of Route 1, Box 63, Jacksonville County of Jackson

State of Oregon do hereby make application for a certificate of registration as evidence of a right to appropriate ground water.

1. Source from which water is withdrawn is pump well  
(Flowing well, pump well, infiltration trench, or tunnel)

2. Location is: 6 miles southwest of Jacksonville, Oregon  
(Approximate distance and direction from nearest city or town)

and is more particularly described as follows:

(a) Approximately 13 chains South and 2.65 chains west of the NE corner of D.L.C. 41  
(Give distance and bearing to corner of section or other legal subdivision)  
being within D.L.C. 41 of Sec. 33 Twp. 38 S Rge. 3 W of W.M.  
(Smallest legal subdivision) (N. or S.) (E. or W.)

or (b) within limits of recorded platted property, town or city: \_\_\_\_\_  
in Lot \_\_\_\_\_ Block \_\_\_\_\_ of \_\_\_\_\_  
(Name of plat or addition)

County of \_\_\_\_\_  
(If within city or town, give name)

3. Construction Work was begun on prior to 1896; was completed on prior to 1896  
(Date) (Date)

and the ground water claimed was first used for the purposes set out below ~~xxx~~ (prior to 1943 and) on or about June 1942.  
(Date)

since which time the water has been used continuously  
(Continuously or Intermittently)

from 1943 to Oct. 4, 1957  
(Date) (Date)

4. Quantity of water claimed and used is 845 gallons per minute; \_\_\_\_\_ acre feet per year.

5. Purpose or Purposes for which water is used: Irrigation of 10 acres of land which includes lawn around house and also for domestic use and stock watering  
(Domestic, irrigation, municipal, manufacturing, industrial, etc.)

6. Description of Well: Depth 16 feet. Type dug  
(Dug or drilled)  
diameter 36 inches. Elevation of ground at well site about 1200 feet, mean sea level.  
(As near as known)

Depth to water table about 5 feet.

7. Capacity of Well: about 845 g.p.m. with 9 feet drawdown.

\_\_\_\_\_ g.p.m. with \_\_\_\_\_ feet drawdown.

Date of test \_\_\_\_\_

If Flowing Well: Measured discharge \_\_\_\_\_ g.p.m. on \_\_\_\_\_  
(Date)


Shut-in pressure at ground surface \_\_\_\_\_ lbs. per sq. in. on \_\_\_\_\_  
(Date)

Water is controlled by \_\_\_\_\_  
(Cap, valve, etc.)





Township 38S Range 3 W W.M.  
North

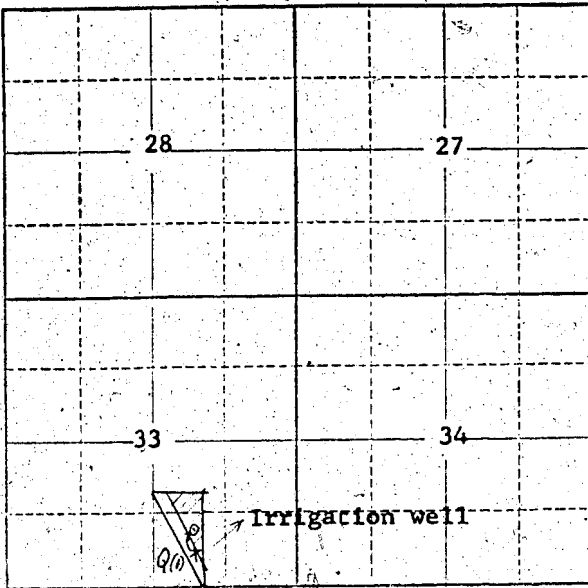

Locate well and acreage of irrigated land on plat.  
Scale: 2" = 1 Mile

STATE OF OREGON

County of Jackson

} ss.

I, Boyd Hamilton, being first duly sworn, do hereby certify that I have read the foregoing Registration Statement and that all of the items therein contained are true to the best of my knowledge and belief.

Boyd Hamilton  
(Signature of Registrant)

Subscribed and sworn to before me this 4th day of October, 1957

My commission expires Sept. 24, 1958

Samuel D. [Signature]  
(Notary Public)

(SEAL)

### CERTIFICATE OF REGISTRATION

STATE OF OREGON

County of Marion

} ss.

This is to certify that the foregoing Registration Statement was received in the office of the State Engineer on the 7th day of October, 1957, at 8:00 o'clock A. M. and has been duly recorded in said office in Book No. 4 of Registration Statements on page GR-652 C.

~~Construction shall be completed by X-X-X-X-X-X-X-X-X-X-X-X and the water completely applied to beneficial use by X-X-X-X-X-X-X-X-X-X-X-X.~~

Witness my hand this 2nd day of January, 1958

Lewis A. Stanley  
(State Engineer)

By \_\_\_\_\_ (Deputy)

GR-652 C