

Registration Statement

OF CLAIMANT OF RIGHT TO APPROPRIATE GROUND WATER

RECEIVED
NOV 15 1957

STATE ENGINEER
SALEM, OREGON

TO THE STATE ENGINEER OF OREGON:

I, City of Haines

of Haines, Oregon

(Mailing address)

County of Baker

State of Oregon, do hereby make application for a certificate of registration as evidence of a right to appropriate ground water.

1. Source from which water is withdrawn is pump well
(Flowing well, pump well, infiltration trench, or tunnel)

2. Location is: in Haines, Oregon near Olson 2nd
(Approximate distance and direction from nearest city or town)

and is more particularly described as follows:

(a) 200 feet west and 100 feet south from center of section 33
(Give distance and bearing to corner of section or other legal subdivision)

being within NE 1/4 of SW 1/4 of Sec. 33, Twp. 7 S, Rge. 39 W
(Smallest legal subdivision) (N. or S.) (E. or W.)

or (b) within limits of recorded platted property, town or city: Haines, Oregon

in Lot _____, Block _____ of Olson 2nd Streets
(Name of plat or addition)

Haines County of Baker
(If within city or town, give name)

3. Construction Work was begun on 1910; was completed on 1910
(Date) (Date)

and the ground water claimed was first used for the purposes set out below on 1910
(Date)

since which time the water has been used continuously
(Continuously or intermittently)

from 1910 to 1957
(Date) (Date)

4. Quantity of water claimed and used is 100,000 gallons per 29 gpm 24 hour period acre feet per year.

5. Purpose or Purposes for which water is used consumption by Haines residents

Municipal Use
(Domestic, irrigation, municipal, manufacturing, industrial, etc.)

6. Description of Well: Depth 160 feet. Type drilled
(Dug or drilled)

diameter 6" inches. Elevation of ground at well site 3333 feet, mean sea level.
(As near as known)

Depth to water table 50' feet.

7. Capacity of Well: not known g.p.m. with _____ feet drawdown.

_____ g.p.m. with _____ feet drawdown.


Date of test none taken

If Flowing Well: Measured discharge _____ g.p.m. on _____
(Date)

Shut-in pressure at ground surface _____ lbs. per sq. in. on _____
(Date)

Water is controlled by _____
(Cap, valve, etc.)

Township 75 Range 39E, W.M.
North

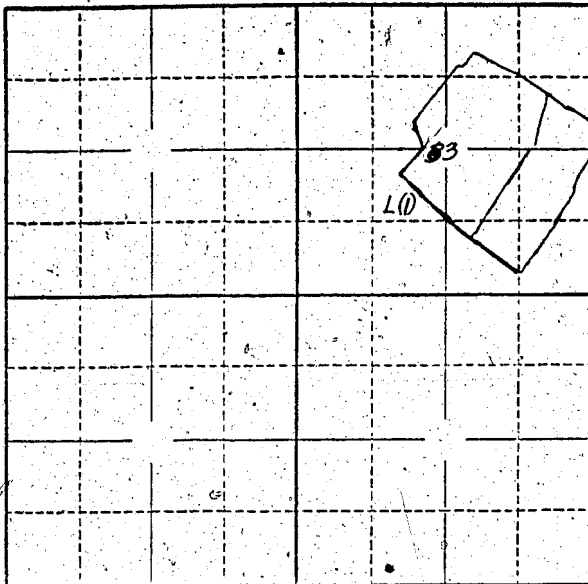

Locate well and acreage of irrigated land on plat.
Scale: 2" = 1 Mile

STATE OF OREGON

County of Haker } ss.

I, Mrs. Lois Coles, being first duly sworn, do hereby certify that I have read the foregoing Registration Statement and that all of the items therein contained are true to the best of my knowledge and belief.

Lois Coles
(Signature of Registrant)

Subscribed and sworn to before me this 9th day of October, 1957.

My commission expires 9-1958

W. W. H. H.
(Notary Public)

(SEAL)

CERTIFICATE OF REGISTRATION

STATE OF OREGON

County of Marion } ss.

This is to certify that the foregoing Registration Statement was received in the office of the State Engineer on the 10th day of October, 1957, at 1:00 o'clock P. M. and has been duly recorded in said office in Book No. 4 of Registration Statements on page GR-653 C.

Witness my hand this 2nd day of January, 1958.

Lewis A. Stanley
(State Engineer)

By _____ (Deputy)

GR - 653 C