

Registration Statement

OF CLAIMANT OF RIGHT TO APPROPRIATE GROUND WATER

(Under Chapter 708, Oregon Laws 1955.)

TO THE STATE ENGINEER OF OREGON:

I, Vallan M. Reynolds, by J. W. Reynolds, Power of Attorney

of Medford County of Jackson

State of Oregon, do hereby make application for a certificate of registration as evidence of a right to appropriate ground water.

1. Source from which water is withdrawn is Pump from infiltration trench (sump)
(Flowing well, pump well, infiltration trench, or tunnel)

2. Location is: Three miles southeast from Medford
(Approximate distance and direction from nearest city or town)

and is more particularly described as follows: 2300 ft South & 1800 ft East from W 1/2 corner of Sec. 5

(a) See Surveyor's description attached
(Give distance and bearing to corner of section or other legal subdivision)

being within SE 1/4 of NW 1/4 of Sec. 5, Twp. 38 S, Rge. 1 W
(Smallest legal subdivision) (N. or S.) (E. or W.)

or (b) within limits of recorded platted property, town or city:

in Lot _____, Block _____ of _____
(Name of plat or addition)

County of _____
(If within city or town, give name)

3. Construction Work was begun on May 2, 1952; was completed on May 2, 1952
(Date) (Date)

and the ground water claimed was first used for the purposes set out below on June 4, 1952
(Date)

since which time the water has been used intermittently for irrigation of pasture,
(Continuously or intermittently)
garden and lawn as required
from June 4, 1952 to July 1957
(Date) (Date)

4. Quantity of water claimed and used is sixty gallons per minute; three acre feet per year.

5. Purpose or Purposes for which water is used irrigation

(Domestic, irrigation, municipal, manufacturing, industrial, etc.)

6. Description of Well: Depth _____ feet. Type _____
(Dug or drilled)

diameter _____ inches. Elevation of ground at well site 1450 feet, mean sea level.
(As near as known)

Depth to water table _____ feet.

7. Capacity of Well: _____ g.p.m. with _____ feet drawdown.

_____ g.p.m. with _____ feet drawdown.


Date of test _____

If Flowing Well: Measured discharge _____ g.p.m. on _____
(Date)

Shut-in pressure at ground surface _____ lbs. per sq. in. on _____
(Date)

Water is controlled by _____
(Cap, valve, etc.)

Township 38 S Range 1 W, W.M.
North

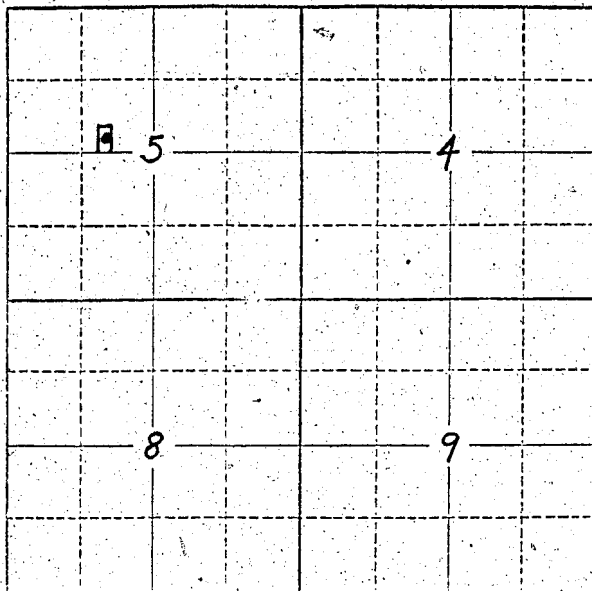

Red dot
is Sump

Locate well and acreage of irrigated land on plat.

Scale: 2" = 1 Mile

STATE OF OREGON

County of Jackson

} ss.

I, J. H. Reynolds, being first duly sworn, do hereby certify that I have read the foregoing Registration Statement and that all of the items therein contained are true to the best of my knowledge and belief.

J. H. Reynolds
(Signature of Registrant)
Power of Attorney.

Subscribed and sworn to before me this 26 day of September, 1957

My commission expires 10-7-57

John F. Stewart
(Notary Public)

(SEAL)

CERTIFICATE OF REGISTRATION

STATE OF OREGON

County of Marion

} ss.

This is to certify that the foregoing Registration Statement was received in the office of the State Engineer on the 17th day of October, 1957, at 1:00 o'clock P.M. and has been duly recorded in said office in Book No. 4 of Registration Statements on page GR-637 C

~~Construction work completed by xxxxxxxxxx in xxx and the water completely applied to beneficial use by xxxxxxxxxx in xxx~~ xx

Witness my hand this 27th day of November, 1957

\$15.00

LEWIS A. STANLEY
(State Engineer)
By [Signature]
(Deputy)

GR-637 C