

Registration Statement

OF CLAIMANT OF RIGHT TO APPROPRIATE GROUND WATER

TO THE STATE ENGINEER OF OREGON:

I, Paul W. Stevenson

of Box 132 Phoenix County of Jackson
(Mailing address)

State of Oregon, do hereby make application for a certificate of registration as evidence of a right to appropriate ground water.

1. Source from which water is withdrawn is Infiltration trench
(Flowing well, pump well, infiltration trench, or tunnel)

2. Location is: one half mile east of Phoenix
(Approximate distance and direction from nearest city or town)

and is more particularly described as follows:

(a) 840 feet North and 1125 feet East from the SW corner Section 10
(Give distance and bearing to corner of section or other legal subdivision)

being within SE 1/4 SW 1/4 of Sec. 10, Twp. 38 S., Rge. 1 W.
(Smallest legal subdivision) (N. or S.) (E. or W.)

or (b) within limits of recorded platted property, town or city:

in Lot _____, Block _____ of _____
(Name of plat or addition)

County of _____
(If within city or town, give name)

3. Construction Work was begun on 2.10.47; was completed on 4.15.47
(Date) (Date)

and the ground water claimed was first used for the purposes set out below on 6.12.47,
(Date)

since which time the water has been used Continuously
(Continuously or Intermittently)

from 6-12-47 to date
(Date) (Date)

4. Quantity of water claimed and used is 140 gallons per minute; 113 acre feet per year.

5. Purpose or Purposes for which water is used Irrigation
(Domestic, irrigation, municipal, manufacturing, industrial, etc.)

(See item 11) Description of Well: Depth 20 feet. Type dug
(Dug or drilled)

diameter 370' x 40' Elevation of ground at well site 1545 feet, mean sea level.
(As near as known)

Depth to water table 10 feet.

7. Capacity of Well: 200 g.p.m. with 10 feet drawdown.

_____ g.p.m. with _____ feet drawdown.

Date of test none

If Flowing Well: Measured discharge _____ g.p.m. on _____
(Date)

Shut-in pressure at ground surface _____ lbs. per sq. in. on _____
(Date)

Water is controlled by _____
(Cap, valve, etc.)

8. Casing: (Give diameter, commercial specifications and depth below ground surface of each casing size.)

..... inch diameter none from to feet

..... inch diameter from to feet

..... inch diameter from to feet

..... inch diameter from to feet

Describe and show depth of shoe, plug, adapter, liner or other details: none

9. Perforated Casings or Screens:

none from to

(Number per foot and size of perforations, or describe screen)

..... from to

..... from to

..... from to

10. Log of Well: (Describe each stratum or formation clearly, indicate if water bearing, and give thickness and depth as indicated.)

MATERIAL	Thickness (Feet)	Depth to Bottom (Feet)
Sandy loam	2	18
Gravel and rock (water bearing after 10 feet)	18	0

If log of well is not available, give name and address of driller. Virgil O. Anderson

1234 Corona Avenue, Medford, Oregon

11. **Infiltration Trench:** Covered or open open
Dimensions: Length 370 ft. Minimum depth 18 ft. Maximum depth 20 ft.

Bottom width 30 ft. Discharge _____ g.p.m. Date of test none

12. **Tunnel:** Type of lining _____

Dimensions: _____
(Length, course, and cross sectional size)

Position of water bearing stratum with reference to portal of tunnel _____

Log of tunnel: (Preceding table for log of well may be used, if desired. Give footage from portal and character of materials, as pertinent.)

13. **Pumping Equipment:**

(a) Pump 4" x 2.5" centrifugal pump Capacity 200 g.p.m.
(Make, type and size)


(b) Motor 60 H.P. gasoline engine
(Type and horsepower)

14. **Location of area irrigated or to be irrigated, or place of use if for purposes other than irrigation.**

Township North or South	Range E. or W. of Willamette Meridian	Section	Forty-acre Tract	Number Acres To Be Irrigated	Date of Reclamation
<u>38 S.</u>	<u>1 W.</u>	<u>10</u>	<u>SW$\frac{1}{4}$ SW$\frac{1}{4}$</u>	<u>5.0 acres</u>	<u>June 1, 1947</u>
<u>"</u>	<u>"</u>	<u>10</u>	<u>SE$\frac{1}{4}$ SW$\frac{1}{4}$</u>	<u>20.0 acres</u>	<u>June 1, 1947</u>
			<u>Total</u>	<u>25.0 acres</u>	

15. If the ground water supply is supplemental to an existing water supply, identification of any application for a permit, permit, certificate or adjudicated right to appropriate water made or held by the registrant. none.

Township 38 S. Range 1 W., W.M.

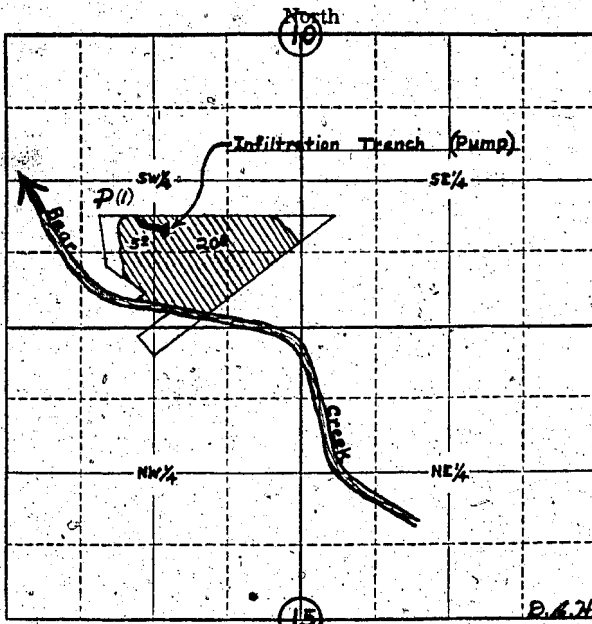

Locate well and acreage of irrigated land on plat.

Scale: 4" = 1 Mile

STATE OF OREGON

County of Jackson } ss.

I, Paul Stevenson, being first duly sworn, do hereby certify that I have read the foregoing Registration Statement and that all of the items therein contained are true to the best of my knowledge and belief.

Paul Stevenson
(Signature of Registrant)

Subscribed and sworn to before me this 16th day of October, 1957.

My commission expires Nov. 23-1960
(Notary Public) Paul Clark

(SEAL)

CERTIFICATE OF REGISTRATION

STATE OF OREGON } ss.
County of Marion

This is to certify that the foregoing Registration Statement was received in the office of the State Engineer on the 17th day of October, 1957, at 1:00 o'clock P.M. and has been duly recorded in said office in Book No. 4 of Registration Statements on page GR-638 C.

Witness my hand this 27th day of November, 1957.

LEWIS A. STAMMETT
(State Engineer)

By [Signature]
(Deputy)

#15.00

GR - 638 C