

# Registration Statement

## OF CLAIMANT OF RIGHT TO APPROPRIATE GROUND WATER

(Under Chapter 703, Oregon Laws 1955.)

TO THE STATE ENGINEER OF OREGON:

I, Fred C. Stockhoff

of R.F.D. # 1, Dayton County of Yamhill

State of Oregon, do hereby make application for a certificate of registration as evidence of a right to appropriate ground water.

1. Source from which water is withdrawn is Pump Well  
(Flowing well, pump well, infiltration trench, or tunnel)

2. Location is: About 8 miles South of Dayton, Oregon  
(Approximate distance and direction from nearest city or town)

and is more particularly described as follows:

(a) 3150' East of Stone At NW Cor Mark Sawyer DLC and SW Cor. Jason Peters DLC.  
(Give distance and bearing to corner of section or other legal subdivision)

being within SW $\frac{1}{4}$  of the SW $\frac{1}{4}$  of of Sec. 21, Twp. 5S, Rge. 3W  
(Smallest legal subdivision) (N. or S.) (E. or W.)

or (b) within limits of recorded platted property, town or city:

in Lot \_\_\_\_\_, Block \_\_\_\_\_ of \_\_\_\_\_  
(Name of plat or addition)

(If within city or town, give name)

County of \_\_\_\_\_

3. Construction Work was begun on About Mar. 20/52 was completed on March 26, 1952  
(Date) (Date)

and the ground water claimed was first used for the purposes set out below on 5/10/52  
(Date)

since which time the water has been used during season  
(Continuously or intermittently)

from 5/14/52 to 12/21/55  
(Date) (Date)

4. Quantity of water claimed and used is 550 gallons per minute; \_\_\_\_\_ acre feet per year.

5. Purpose or Purposes for which water is used Irrigation

(Domestic, irrigation, municipal, manufacturing, industrial, etc.)

6. Description of Well: Depth 138' feet. Type Rotary drilled (gravel packed)  
(Dug or drilled)

diameter 16" casing inches. Elevation of ground at well site 150 feet, mean sea level.  
(As near as known)

Depth to water table 20 feet.

7. Capacity of Well: 600 g.p.m. with 22 feet drawdown.

300 g.p.m. with 79 feet drawdown. No pressure

Date of test About Apr. 1, 1952  
Test was made by M. Van (Portland)

If Flowing Well: Measured discharge \_\_\_\_\_ g.p.m. on \_\_\_\_\_  
(Date)

Shut-in pressure at ground surface \_\_\_\_\_ lbs. per sq. in. on \_\_\_\_\_  
(Date)

Water is controlled by \_\_\_\_\_  
(Cap, valve, etc.)



If log of well is not available, give name and address of driller: .....

11. Infiltration Trench: Covered or open .....

Dimensions: Length ..... ft. Minimum depth ..... ft. Maximum depth ..... ft.

Bottom width ..... ft. Discharge ..... g.p.m. Date of test .....

12. Tunnel: Type of lining .....

Dimensions: .....  
(Length, course, and cross sectional size)

Position of water bearing stratum with reference to portal of tunnel .....

Log of tunnel: (Preceding table for log of well may be used, if desired. Give footage from portal and character of materials, as pertinent.)

13. Pumping Equipment:

(a) Pump *Pomona P 1621* DISCHARGE HEAD ..... Capacity *5.50* g.p.m.  
(Make, type and size)


(b) Motor *40 H.P. G.E. VERTICAL HOLLOW SHAFT* .....  
(Type and horsepower)

14. Location of area irrigated or to be irrigated, or place of use if for purposes other than irrigation.

Township North or South	Range E. or W. of Willamette Meridian	Section	Forty-acre Tract	Number Acres To Be Irrigated	Date of Reclamation
5 S	3 W	20	NE $\frac{1}{4}$ of the SE $\frac{1}{4}$	5 Ac.	May 1952
"	"	"	SE $\frac{1}{4}$ of the SE $\frac{1}{4}$	30 Ac.	
"	"	21	NE $\frac{1}{4}$ of the SW $\frac{1}{4}$	10 Ac.	
"	"	"	NW $\frac{1}{4}$ of the SW $\frac{1}{4}$	12 Ac.	
"	"	"	SE $\frac{1}{4}$ of the SW $\frac{1}{4}$	26 Ac.	
"	"	"	SW $\frac{1}{4}$ of the SW $\frac{1}{4}$	10 Ac.	
"	"	28	NE $\frac{1}{4}$ of the NW $\frac{1}{4}$	11 Ac.	
"	"	"	NW $\frac{1}{4}$ of the NW $\frac{1}{4}$	13 Ac.	
"	"	29	NE $\frac{1}{4}$ of the NE $\frac{1}{4}$	10 Ac.	
	In all			157 Acres	

15. If the ground water supply is supplemental to an existing water supply, identification of any application for a permit, permit, certificate or adjudicated right to appropriate water made or held by the registrant.

Township 5S Range 3W, W.M.  
North

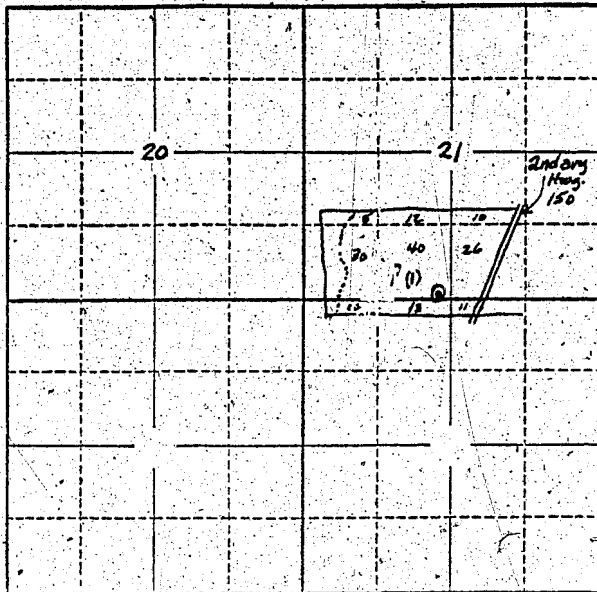

Locate well and acreage of irrigated land on plat.  
Scale: 2" = 1 Mile

STATE OF OREGON

County of Yamhill

ss.

I, Fred C. Stockhoff being first duly sworn, do hereby certify that I have read the foregoing Registration Statement and that all of the items therein contained are true to the best of my knowledge and belief.

Fred C. Stockhoff  
(Signature of Registrant)

Subscribed and sworn to before me this 15th day of December, 1955

My commission expires February 10, 1956

Frank Chamber  
(Notary Public)

(SEAL)

**CERTIFICATE OF REGISTRATION**

STATE OF OREGON

County of Marion

ss.

This is to certify that the foregoing Registration Statement was received in the office of the State Engineer on the 21st day of December, 1955, at 10:20 o'clock A. M. and has been duly recorded in said office in Book No. 1 of Registration Statements on page 5B

Construction shall be completed by \_\_\_\_\_, 19\_\_\_\_, and the water <sup>is</sup> completely applied to beneficial use by \_\_\_\_\_, 19\_\_\_\_

Witness my hand this 24th day of February, 1956

Laura A. Stanley  
(State Engineer)

By \_\_\_\_\_  
(Deputy)

GR-58 C