

Registration Statement

OF CLAIMANT OF RIGHT TO APPROPRIATE GROUND WATER

TO THE STATE ENGINEER OF OREGON:

I, Wilfred H. Cook Property known as Cooks Garden
of R. 2, Box 95 Eugene County of Lane
(Mailing address)

State of Ore, do hereby make application for a certificate of registration as evidence of a right to appropriate ground water.

1. Source from which water is withdrawn is Pump well
(Flowing well, pump well, infiltration trench, or tunnel)

2. Location is: 2 miles west of Springfield Ore
(Approximate distance and direction from nearest city or town)

and is more particularly described as follows:

(a) 600 feet north and 400 feet west from SE corner of section 28
(Give distance and bearing to corner of section or other legal subdivision)

being within SE 1/4 of the SE 1/4 of Sec. 28 Twp. 17 S, Rge. 3 West
(Smallest legal subdivision) (N. or S.) (E. or W.)

or (b) within limits of recorded platted property, town or city:

in Lot _____, Block _____ of _____
(Name of plat or addition)

County of Lane
(If within city or town, give name)

3. Construction Work was begun on Sept 1934, was completed on Oct 1934
(Date) (Date)

and the ground water claimed was first used for the purposes set out below on same
(Date)

since which time the water has been used Seasonally
(Continuously or intermittently)

from June 15 to Oct 15
(Date) (Date)

4. Quantity of water claimed and used is 1 35 gallons per minute; 15 acre feet per year.

5. Purpose or Purposes for which water is used Irrigation
(Domestic, irrigation, municipal, manufacturing, industrial, etc.)

6. Description of Well: Depth 32 feet. Type Dug
(Dug or drilled)

diameter _____ inches. Elevation of ground at well site 432 ft. feet, mean sea level.
(As near as known)

Depth to water table: 17 feet.

7. Capacity of Well: _____ g.p.m. with _____ feet drawdown.

_____ g.p.m. with _____ feet drawdown.


Date of test _____

If Flowing Well: Measured discharge _____ g.p.m. on _____
(Date)

Shut-in pressure at ground surface _____ lbs. per sq. in. on _____
(Date)

Water is controlled by _____
(Cap, valve, etc.)

Township 17 S Range 3 W, W.M.
North

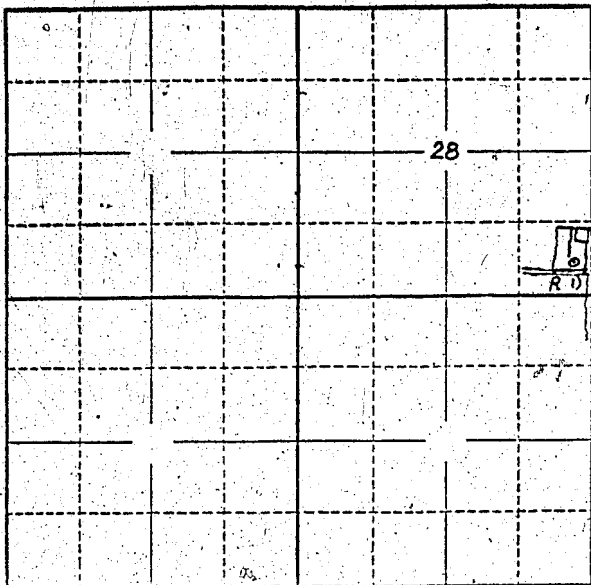

Locate well and acreage of irrigated land on plat.
Scale: 2" = 1 Mile

STATE OF OREGON

County of Lane

} ss.

I, Wilfred H. Cook, being first duly sworn, do hereby certify that I have read the foregoing Registration Statement and that all of the items therein contained are true to the best of my knowledge and belief.

Wilfred H. Cook
(Signature of Registrant)

Subscribed and sworn to before me this 26 day of Oct., 1957

My commission expires May 9, 1960

John O. Elbert
(Notary Public)

(SEAL)

CERTIFICATE OF REGISTRATION

STATE OF OREGON

County of Marion

} ss.

This is to certify that the foregoing Registration Statement was received in the office of the State Engineer on the 28th day of October, 1957, at 8:00 o'clock A. M. and has been duly recorded in said office in Book No. 4 of Registration Statements on page GR-718 C.

Witness my hand this 24th day of January, 1958

Leura A. Stanley
(State Engineer)

By

(Deputy)

GR - 713 C