REGISTRATION NO. GR 623

CERTIFICATE NO. GR-645

# Registration Statement

## OF CLAIMANT OF RIGHT TO APPROPRIATE GROUND WATER

(Under Chapter 708, Oregon Laws 1955.)

**TO THE STATE ENGINEER OF OREGON:**

I, Alvin R. Root,

of Route 1, Box 384, Corvallis County of Benton

State of Oregon; do hereby make application for a certificate of registration as evidence of a right to appropriate ground water.

1. **Source** from which water is withdrawn is pump well
(Flowing well, pump well, infiltration trench, or tunnel)

2. **Location** is: 6 miles NE Corvallis
(Approximate distance and direction from nearest city or town);

and is more particularly described as follows: 526' S 75° 50' E from point in the west line of the David S'roud DLC 44, 31.465 chains S 0° 13' W

(a) from NW corner of claim; said well
(Give distance and bearing to corner of section or other legal subdivision)

being within SE¼ SE¼ of Sec. 6, Twp. 11S (N. or S.), Rge. 1W (E. or W.)
(Smallest legal subdivision)

or (b) within limits of recorded platted property, town or city:

in Lot ..... Block ..... of ..... (Name of plat or addition)

..... County of .....
(If within city or town, give name)

3. **Construction Work** was begun on 1951 (Date); was completed on 1952 (Date)

and the ground water claimed was first used for the purposes set out below on 1952 (Date),

since which time the water has been used continuously
(Continuously or intermittently)

from 1952 (Date) to 1957 (Date)

4. **Quantity** of water claimed and used is 180 gallons per minute; 80 acre feet per year.

5. **Purpose or Purposes** for which water is used irrigation
(Domestic, irrigation, municipal, manufacturing, industrial, etc.)

6. **Description of Well:** Depth 42 feet. Type drilled (Dug or drilled)

diameter 10 inches. Elevation of ground at well site [redacted] 222 (As near as known) feet, mean sea level.

Depth to water table 11 feet.

7. **Capacity of Well:** 260 g.p.m. with 11 feet drawdown.

..... g.p.m. with ..... feet drawdown.

Date of test 1952

**If Flowing Well:** Measured discharge ..... g.p.m. on ..... (Date)

Shut-in pressure at ground surface ..... lbs. per sq. in. on ..... (Date)

Water is controlled by ..... (Cap, valve, etc.)

8. **Casing:** (Give diameter, commercial specifications and depth below ground surface of each casing size.)

10 inch diameter steel casing from surface to 38 feet

..... inch diameter ..... from ..... to ..... feet

..... inch diameter ..... from ..... to ..... feet

..... inch diameter ..... from ..... to ..... feet

Describe and show depth of shoe, plug, adapter, liner or other details: .....

9. **Perforated Casings or Screens:**

Screen section, type unknown from 38 to 42
(Number per foot and size of perforations, or describe screen)

..... from ..... to .....

..... from ..... to .....

..... from ..... to .....

10. **Log of Well:** (Describe each stratum or formation clearly, indicate if water bearing, and give thickness and depth as indicated.)

| MATERIAL | Thickness (Feet) | Depth to Bottom (Feet) |
|---|---|---|
| | | |

GR-645 A

If log of well is not available, give name and address of driller. Bill Hamilton, Albany, Oregon

11. **Infiltration Trench:** Covered or open .....

Dimensions: Length ..... ft. Minimum depth ..... ft. Maximum depth ..... ft.

Bottom width ..... ft. Discharge ..... g.p.m. Date of test .....

12. **Tunnel:** Type of lining .....

Dimensions: .....
(Length, course, and cross sectional size)

Position of water bearing stratum with reference to portal of tunnel .....

Log of tunnel: (Preceding table for log of well may be used, if desired. Give footage from portal and character of materials, as pertinent.)

13. **Pumping Equipment:**

(a) Pump Jacuzzi turbine (Make, type and size) Capacity 350 g.p.m.

(b) Motor 10 hp electric, 3 phase (Type and horsepower)

14. Location of area irrigated or to be irrigated, or place of use if for purposes other than irrigation.

| Township North or South | Range E. or W. of Willamette Meridian | Section | Forty-acre Tract | Number Acres To Be Irrigated | Date of Reclamation |
|---|---|---|---|---|---|
| 11S | 4W | 5 | NW¼ SW¼ | 14.0 | 1952 |
| 11S | 4W | 5 | SW¼ SW¼ | 9.5 | 1952-1954 |
| 11S | 4W | 6 | NE¼ SE¼ | 7.5 | 1952 |
| 11S | 4W | 6 | SE¼ SE¼ | 8.0 | 1952-1954 |
| | | | | 39.0 | |

15. If the ground water supply is supplemental to an existing water supply, identification of any application for a permit, permit, certificate or adjudicated right to appropriate water made or held by the registrant.

GR- 645 B

Township 11 S Range 4 W, W.M.

North

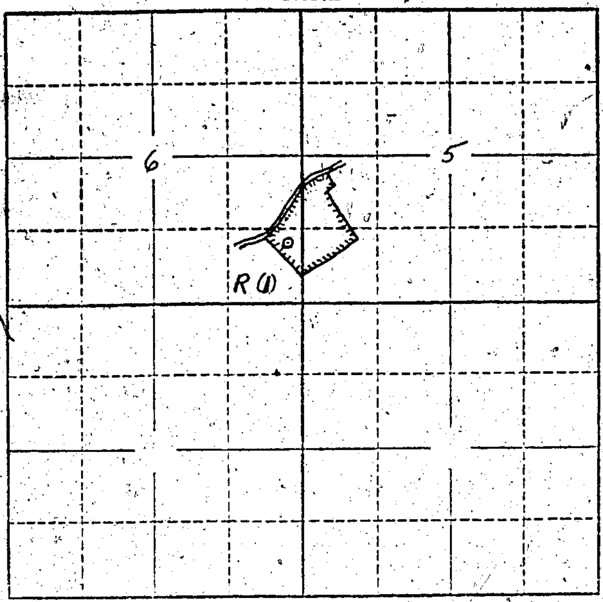


Locate well and acreage of irrigated land on plat.

Scale: 2" = 1 Mile

STATE OF OREGON }
County of Benton } ss.

I, Alvin R. Reed, being first duly sworn, do hereby certify that I have read the foregoing Registration Statement and that all of the items therein contained are true to the best of my knowledge and belief.

Alvin R. Reed
(Signature of Registrant)

Subscribed and sworn to before me this 30 day of October, 1957

My commission expires Nov 16 1960 Eunice V. Parker
(Notary Public)

(SEAL)

## CERTIFICATE OF REGISTRATION

STATE OF OREGON }
County of Marion } ss.

This is to certify that the foregoing Registration Statement was received in the office of the State Engineer on the 31st day of October, 19 57, at 8:00 o'clock A. M. and has been duly recorded in said office in Book No. 4 of Registration Statements on page GR-645 C

xx ~~Construction shall be completed by x-x-x-x-x-x-x-x-x 19x-x-x and the water completely applied x x on or before by x-x-x-x-x-x-x-x-x 19x-x-x~~ xx

Witness my hand this 27th day of November, 19 57.

LEWIS A. STANLEY
(State Engineer)

$16.35

By Max A. Rogers
(Deputy)

GR-645 C