

Registration Statement

REGISTRATION NO. GR 677CERTIFICATE NO. GR-675

OF CLAIMANT OF RIGHT TO APPROPRIATE GROUND WATER

(Under Chapter 708, Oregon Laws 1955.)

TO THE STATE ENGINEER OF OREGON:

I, State of Oregon, Oregon State Hospitalof Salem County of MarionState of Oregon, do hereby make application for a certificate of registration as evidence of a right to appropriate ground water.1. Source from which water is withdrawn is Flowing well No. 4
(Flowing well, pump well, infiltration trench, or tunnel)2. Location is: Within Salem City Limits
(Approximate distance and direction from nearest city or town)

and is more particularly described as follows:

(a) 867 ft. South & 2600 West of NE Corner Section 25 Twp. 7S Rge. 3W
(Give distance and bearing to corner of section or other legal subdivision)being within NE 1/4 NW 1/4 of Sec. 25, Twp. 7S, Rge. 3W
(Smallest legal subdivision) (N. or S.) (E. or W.)

or (b) within limits of recorded platted property, town or city:

in Lot _____, Block _____ of _____
(Name of plat or addition)Salem County of Marion
(If within city or town, give name)3. Construction Work was begun on Fall 1928; was completed on Fall 1928
(Date) (Date)and the ground water claimed was first used for the purposes set out below on March 1929
(Date)since which time the water has been used Intermittently
(Continuously or intermittently)from March 1929 to Present
(Date) (Date)4. Quantity of water claimed and used is 150 gallons per minute; 244 acre
feet per year.5. Purpose or Purposes for which water is used Domestic

(Domestic, irrigation, municipal, manufacturing, industrial, etc.)

6. Description of Well: Depth 117.5 feet. Type Flowing
(Dug or drilled)diameter 12 inches. Elevation of ground at well site 202.11 feet, mean sea level.
(As near as known)Depth to water table 33.5 feet.

7. Capacity of Well: _____ g.p.m. with _____ feet drawdown.

_____ g.p.m. with _____ feet drawdown.

Date of test Information not availableIf Flowing Well: Measured discharge _____ g.p.m. on _____
(Date)Shut-in pressure at ground surface _____ lbs. per sq. in. on _____
(Date)Water is controlled by _____
(Cap, valve, etc.)

12 inch diameter from 0 to 112 feet
 inch diameter from to feet
 inch diameter from to feet
 inch diameter from to feet

85 ft

Information not available.

(Number per foot and size of perforations, or describe screen)

from _____ to _____

from to

from to

from to

[illegible]

GR- 675 A

11. Infiltration Trench: Covered or open

Bottom width ft. Discharge g.p.m. Date of test

Dimensions: _____
(Length, course, and cross sectional size)

Position of water bearing stratum with reference to portal of tunnel

13. Pumping Equipment:


(a) Pump Bryon Jackson Turbine 4" Capacity 150 g.p.m.
(Make, type and size)

(b) Motor GE Type FT510Y 20 hp. (Type and horsepower)

[illegible]

GR- 675 B

Township 7S Range 3W W.M.
North

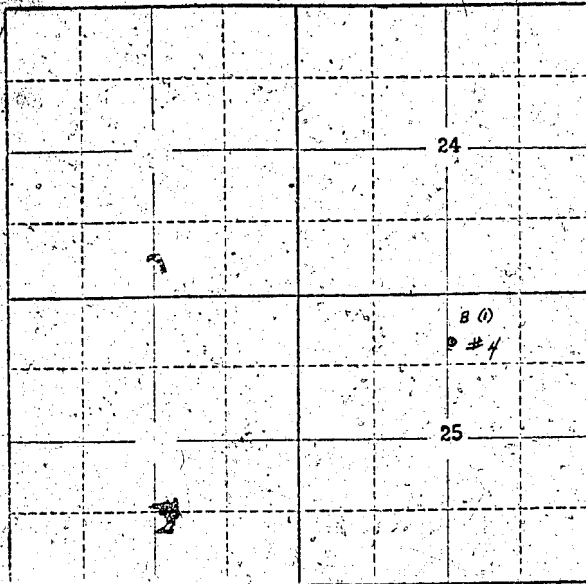

Locate well and acreage of irrigated land on plat.

Scale: 2" = 1 Mile

STATE OF OREGON

County of Marion

ss.

I, D. K. Brooks, M. D., being first duly sworn, do hereby certify that I have read the foregoing Registration Statement and that all of the items therein contained are true to the best of my knowledge and belief.

D. K. Brooks

(Signature of Registrant)

Subscribed and sworn to before me this 18 day of October, 1957, 19.

My commission expires Commission Expires Sept. 23, 1960

Pauline E. Keeling

(Notary Public)

(SEAL)

CERTIFICATE OF REGISTRATION

STATE OF OREGON

County of Marion

ss.

This is to certify that the foregoing Registration Statement was received in the office of the State Engineer on the 16th day of December, 1957, at 8:00 o'clock A.M. and has been duly recorded in said office in Book No. 4 of Registration Statements on page GR-675 C

Construction shall be completed by 10-10-58 and the water completely applied to beneficial use by 10-10-58

Witness my hand this 21st day of January, 1958

Leura A. Stanley

(State Engineer)

By

(Deputy)

GR-675 C