

Registration Statement

OF CLAIMANT OF RIGHT TO APPROPRIATE GROUND WATER

TO THE STATE ENGINEER OF OREGON:

I, State of Oregon, Oregon State Hospital

of Station A, Salem County of Marion
(Mailing address)

State of Oregon, do hereby make application for a certificate of registration as evidence of a right to appropriate ground water.

1. Source from which water is withdrawn is Pump well #6
(Flowing well, pump well, infiltration trench, or tunnel)

2. Location is: 4 miles SW of Salem city limits
(Approximate distance and direction from nearest city or town)

and is more particularly described as follows:

(a) 352 ft. South & 376 ft. West of NE Corner of Sec. 35 Twp. 7S Rge. 4W
(Give distance and bearing to corner of section or other legal subdivision)

being within NE 1/4 of NE 1/4 of Sec. 35, Twp. 7S, Rge. 4W
(Smallest legal subdivision) (N. or S.) (E. or W.)

or (b) within limits of recorded platted property, town or city:

in Lot _____, Block _____ of _____
(Name of plat or addition)

(If within city or town, give name) County of _____

3. Construction Work was begun on 1920 APPX.; was completed on 1920
(Date) (Date)

and the ground water claimed was first used for the purposes set out below on 1920
(Date)

since which time the water has been used Intermittently
(Continuously or Intermittently)

from 1920 to 1957
(Date) (Date)

4. Quantity of water claimed and used is 150 gallons per minute; 89 acre feet per year.

5. Purpose or Purposes for which water is used Irrigation

(Domestic, irrigation, municipal, manufacturing, industrial, etc.)

6. Description of Well: Depth 50 feet. Type Drilled
(Dug or drilled)

diameter 12 inches. Elevation of ground at well site 147.6 feet, mean sea level.
(As near as known)

Depth to water table 12 feet.

7. Capacity of Well: _____ g.p.m. with _____ feet drawdown.

_____ g.p.m. with _____ feet drawdown.

Date of test Information not available.

If Flowing Well: Measured discharge _____ g.p.m. on _____
(Date)

Shut-in pressure at ground surface _____ lbs. per sq. in. on _____
(Date)

Water is controlled by _____
(Cap, valve, etc.)

12	inch diameter	from	0	to	50	feet
	inch diameter	from		to		feet
	inch diameter	from		to		feet
	inch diameter	from		to		feet

Describe and show depth of shoe, plug, adapter, liner or other details:

Information not available from to
(Number per foot and size of perforations, or describe screen).

(Number per foot and size of perforations, or describe screen)

from to

from to

from _____ to _____

[illegible]

11. Infiltration Trench: Covered or open

Bottom width ft. Discharge g.p.m. Date of test

12. Tunnel: Type of lining

Position of water bearing stratum with reference to portal of tunnel


13. Pumping Equipment:

(b) Motor Wisconsin 33HP Gas Engine
(Type and horsepower)

[illegible]

15237 - 19654

Township 7S Range 4W W.M.
North

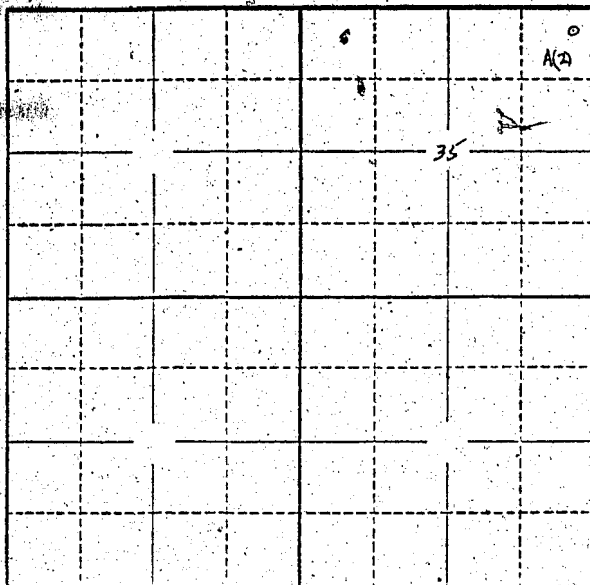

Locate well and acreage of irrigated land on plat.

Scale: 2" = 1 Mile

STATE OF OREGON

County of Marion } ss.

I, D. L. Brook, being first duly sworn, do hereby certify that I have read the foregoing Registration Statement and that all of the items therein contained are true to the best of my knowledge and belief.

[Signature]
(Signature of Registrant)

Subscribed and sworn to before me this 18th day of October, 1957

My commission expires MY COMMISSION EXPIRES JULY 23, 1960

[Signature]
(Notary Public)

(SEAL)

CERTIFICATE OF REGISTRATION

STATE OF OREGON

County of Marion } ss.

This is to certify that the foregoing Registration Statement was received in the office of the State Engineer on the 16th day of December, 1957 at 8:00 o'clock A. M. and has been duly recorded in said office in Book No. 1 of Registration Statements on page GR-680 C.

Witness my hand this 21st day of January, 1958

[Signature]
(State Engineer)

By

(Deputy)

GR - 680 C