

Registration Statement

REGISTRATION NO. CL 696
CERTIFICATE NO. GR 2439

OF CLAIMANT OF RIGHT TO APPROPRIATE GROUND WATER

(Under Chapter 708, Oregon Laws 1955.)

RECEIVED
MAY 1 1957
STATE ENGINEER
SALEBY OREGON

TO THE STATE ENGINEER OF OREGON:

I, Melvin Toothman

of Grants Pass County of Josephine

State of Oregon do hereby make application for a certificate of registration as evidence of a right to appropriate ground water.

1. Source from which water is withdrawn is Pump Well
(Flowing well, pump well, infiltration trench, or tunnel)
2. Location is: 7 1/2 or 8 mi North Grants Pass
(Approximate distance and direction from nearest city or town)

and is more particularly described as follows:

(a) 1675 Lot 20 of Ed. Gov. corner 4 70 ft North
(Give distance and bearing to corner of section or other legal subdivision)

being within S. W 4 S E 4 of Sec. 10, Twp. 35 S, Rge. 6 W
(Smallest legal subdivision) (N. or S.) (E. or W.)

(b) within limits of recorded platted property, town or city:

in Lot _____, Block _____ of _____
(Name of plat or addition)

County of Josephine
(If within city or town, give name)

3. Construction Work was begun on 9/28/52; was completed on 10/5/52
(Date) (Date)

and the ground water claimed was first used for the purposes set out below on 10/10/52
(Date)

since which time the water has been used _____
(Continuously or Intermittently)

from 10/10/52 to 1958
(Date) (Date)

4. Quantity of water claimed and used is 50 gallons per minute; _____ acre feet per year.

5. Purpose or Purposes for which water is used Irrigation & Stock

(Domestic, irrigation, municipal, manufacturing, industrial, etc.)

6. Description of Well: Depth 195 feet. Type Drilled
(Dug or drilled)

diameter 8 inches. Elevation of ground at well site 980 feet, mean sea level.
(As near as known)

Depth to water table 50 feet.

7. Capacity of Well: 50 g.p.m. with 10 feet drawdown.

80 g.p.m. with 70 feet drawdown.


Date of test 10/16/52 & 3/6/57

If Flowing Well: Measured discharge _____ g.p.m. on _____
(Date)

Shut-in pressure at ground surface _____ lbs. per sq. in. on _____
(Date)

Water is controlled by _____
(Cap, valve, etc.)

Township 35s Range 6w W.M.
North

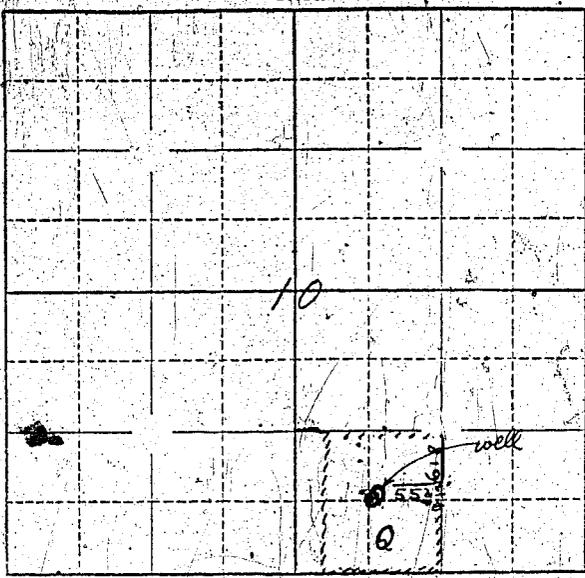

Locate well and acreage of irrigated land on plat.

Scale: ~~2"~~ - 1/2 Mile
4" - 1 Mile

STATE OF OREGON

County of Josephine } ss.

I, Melvin M. Toothman, being first duly sworn, do hereby certify that I have read the foregoing Registration Statement and that all of the items therein contained are true to the best of my knowledge and belief.

Melvin M. Toothman
(Signature of Registrant)

Subscribed and sworn to before me this 31st day of October, 1957.

My commission expires Feb. 27, 1961
(Notary Public)

(SEAL)

CERTIFICATE OF REGISTRATION

STATE OF OREGON } ss.
County of Marion

This is to certify that the foregoing Registration Statement was received in the office of the State Engineer on the ~~1st~~ 1st day of November, 1957, at 8:00 o'clock A.M. and has been duly recorded in said office in Book No. 11 of Registration Statements on page GR-2439

~~Construction shall be completed by 1958 and the water completely applied for benefit by 1958.~~

Witness my hand this 16th day of March, 1959.

Clara A. [Signature]
(State Engineer)

\$15.00

By _____ (Deputy)

GR-2439