

Registration No. GR-688

Certificate No. GR-654

Registration Statement

OF CLAIMANT OF RIGHT TO APPROPRIATE GROUND WATER

TO THE STATE ENGINEER OF OREGON:

I, D. L. Perry Adams
of RT #3 Junction City Ave County of Lane
(Mailing address)
State of Oregon, do hereby make application for a certificate of registration as evidence of a right to appropriate ground water.

1. Source from which water is withdrawn is Well #1
(Flowing well, pump well, infiltration trench, or tunnel)

2. Location is: 3 1/2 Mi. N. of Junction City Ave
(Approximate distance and direction from nearest city or town)

and is more particularly described as follows:

(a) 3/4 Mi. North 700 feet South and 132 feet West from NE corner 18
SE 1/4 of NE 1/4 (Give distance and bearing to corner of section or other legal subdivision)
being within Northern Flat of Sec. 18, Twp. 15S, Rge. 4W
(Smallest legal subdivision) (N. or S.) (E. or W.)

or (b) within limits of recorded platted property, town or city:

in Lot _____, Block _____ of _____
(Name of plat or addition)

County of _____
(If within city or town, give name)

3. Construction Work was begun on June 1952; was completed on June 1952
(Date) (Date)

and the ground water claimed was first used for the purposes set out below on June 1952
(Date)

since which time the water has been used Continuously
(Continuously or Intermittently)

from June 1952 to Oct 1957
(Date) (Date)

4. Quantity of water claimed and used is 300 gallons per minute; 2 1/2 acre feet per year.

5. Purpose or Purposes for which water is used Irrigation

(Domestic, irrigation, municipal, manufacturing, industrial, etc.)

6. Description of Well: Depth 29 feet. Type Drilled
(Dug or drilled)

diameter 4 inches. Elevation of ground at well site 300 FT. feet, mean sea level.
(As near as known)

Depth to water table 12 feet.

7. Capacity of Well: 450 g.p.m. with 2 feet drawdown.

_____ g.p.m. with _____ feet drawdown.


Date of test June 1952

If Flowing Well: Measured discharge _____ g.p.m. on _____
(Date)

Shut-in pressure at ground surface _____ lbs. per sq. in. on _____
(Date)

Water is controlled by _____
(Cap, valve, etc.)

Township 15S Range 4W W.M.
North

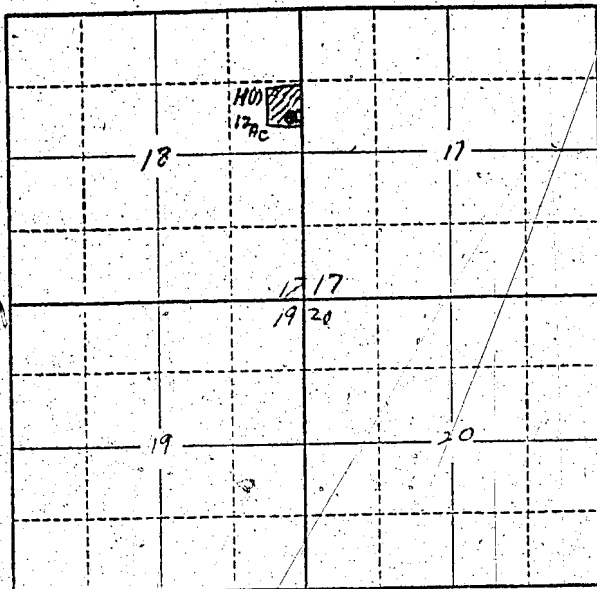

Locate well and acreage of irrigated land on plat.
Scale: 2" = 1 Mile

STATE OF OREGON

County of Linn

} ss.

I, D. LeRoy Adams, being first duly sworn, do hereby certify that I have read the foregoing Registration Statement and that all of the items therein contained are true to the best of my knowledge and belief.

D. LeRoy Adams
D. LeRoy Adams
(Signature of Registrant)

Subscribed and sworn to before me this 26th day of November 1957

My commission expires Aug. 10, 1959

Ray Zehn
(Notary Public)

(SEAL)

CERTIFICATE OF REGISTRATION

STATE OF OREGON

County of Marion

} ss.

This is to certify that the foregoing Registration Statement was received in the office of the State Engineer on the 5th day of November, 1957, at 8:00 o'clock A. M. and has been duly recorded in said office in Book No. 4 of Registration Statements on page GR-654 C.

Witness my hand this 2nd day of January 1958

Lewis A. Stanley
(State Engineer)

By

(Deputy)

GR - 654 C