

Registration No. GR 699

Certificate No. GR 655

Registration Statement

OF CLAIMANT OF RIGHT TO APPROPRIATE GROUND WATER

TO THE STATE ENGINEER OF OREGON:

I, P. Le Roy Adams
of Rt #3 Junction City Oregon County of Lane
State of Oregon, do hereby make application for a certificate of registration as evidence of a right to appropriate ground water.

- 1. Source from which water is withdrawn is Well
(Flowing well, pump well, infiltration trench, or tunnel)
- 2. Location is: 3/4 Mi North of Junction City
(Approximate distance and direction from nearest city or town)

and is more particularly described as follows:

- (a) 3/4 Mi North 1900 feet South and 493 feet east from NW Corner Sect 17
(Give distance and bearing to corner of section or other legal subdivision)
being within Lot 2 S.W. 1/4 of NW 1/4 of Sec. 17, Twp. 15 S, Rge. 4 W
(Smallest legal subdivision) (T. or S.) (R. or W.)
- or (b) within limits of recorded platted property, town or city?

in Lot _____, Block _____ of _____
(Name of plat or addition)
County of _____
(If within city or town, give name)

3. Construction Work was begun on May 1951; was completed on May 1951
(Date) (Date)
and the ground water claimed was first used for the purposes set out below on June 1951
(Date)
since which time the water has been used Continuously
(Continuously or Intermittently)
from June 1951 to Sept 1957
(Date) (Date)

4. Quantity of water claimed and used is 300 gallons per minute; 2 1/2 acre feet per year.

5. Purpose or Purposes for which water is used 1. Irrigation
(Domestic, irrigation, municipal, manufacturing, industrial, etc.)

6. Description of Well: Depth 29 feet. Type Drilled
(Dug or drilled)
diameter 6 inches. Elevation of ground at well site 300 feet, mean sea level.
(As near as known)
Depth to water table 12 feet.

7. Capacity of Well: 400 g.p.m. with 3 feet drawdown.
_____ g.p.m. with _____ feet drawdown.

Date of test June 1951
If Flowing Well: Measured discharge _____ g.p.m. on _____
(Date)
Shut-in pressure at ground surface _____ lbs. per sq. in. on _____
(Date)
Water is controlled by _____
(Cap. valve, etc.)

8. Casing: (Give diameter, commercial specifications and depth below ground surface of each casing size.)

~~6~~ 6 inch diameter from 0 to 29 feet
..... inch diameter from to feet
..... inch diameter from to feet
..... inch diameter from to feet

Describe and show depth of shoe, plug, adapter, liner or other details:

9. Perforated Casings or Screens:

..... *6/16 Kn. 1/8 in.* from to
(Number per foot and size of perforations, or describe screen)
..... from to
..... from to
..... from to

10. Log of Well: (Describe each stratum or formation clearly, indicate if water bearing, and give thickness and depth as indicated.)

MATERIAL	Thickness (Feet)	Depth to Bottom (Feet)

If log of well is not available, give name and address of driller. EVERETT SCOTT

Harrisburg Oregon

11. Infiltration Trench: Covered or open

Dimensions: Length ft. Minimum depth ft. Maximum depth ft.

Bottom width ft. Discharge g.p.m. Date of test

12. Tunnel: Type of lining

Dimensions: (Length, course, and cross sectional size)

Position of water bearing stratum with reference to portal of tunnel

Log of tunnel: (Preceding table for log of well may be used, if desired. Give footage from portal and character of materials, as pertinent.)

13. Pumping Equipment:

(a) Pump Pacific Hi Speed 3x4 Capacity 300 g.p.m.
(Make, type and size)


(b) Motor General Electric 15 HP
(Type and horsepower)

14. Location of area irrigated or to be irrigated, or place of use if for purposes other than irrigation.

Township North or South	Range E. or W. of Willamette Meridian	Section	Forty-acre Tract	Number Acres To Be Irrigated	Date of Reclamation
15S	4W	17	SW 1/4 & NE 1/4	21	1951

15. If the ground water supply is supplemental to an existing water supply, identification of any application for a permit, permit, certificate or adjudicated right to appropriate water made or held by the registrant.

Township 15 S. Range 4 W., W.M.
North

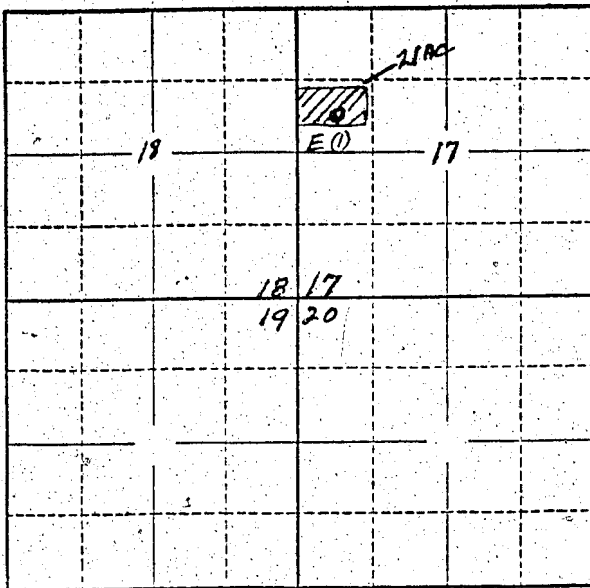

Locate well and acreage of irrigated land on plat.

Scale: 2" = 1 Mile

STATE OF OREGON

County of Linn } ss.

I, D. Leroy Adams, being first duly sworn, do hereby certify that I have read the foregoing Registration Statement and that all of the items therein contained are true to the best of my knowledge and belief.

D. Leroy Adams
(Signature of Registrant)

Subscribed and sworn to before me this 26th day of November, 1957.

My commission expires Aug. 10, 1959.

Ray John
(Notary Public)

(SEAL)

CERTIFICATE OF REGISTRATION

STATE OF OREGON } ss.
County of Marion

This is to certify that the foregoing Registration Statement was received in the office of the State Engineer on the 5th day of November, 1957; at 8:00 o'clock A. M. and has been duly recorded in said office in Book No. 4 of Registration Statements on page GR-655 C.

Witness my hand this 2nd day of January, 1958.

Lewis A. Stanley
(State Engineer)

By _____ (Deputy)

GR - 655 C