

RECEIVED
SEP 2 1955

STATE ENGINEER
SALEM, OREGON

REGISTRATION NO. GR-7
CERTIFICATE NO. GR-6

Registration Statement

RECEIVED
NOV 1 1955

STATE ENGINEER
SALEM, OREGON

OF CLAIMANT OF RIGHT TO APPROPRIATE GROUND WATER.

(Under Chapter 703, Oregon Laws 1955.)

TO THE STATE ENGINEER OF OREGON:

I, J. C. Boyle Route 2, Box 495
of Medford County of Jackson

State of Oregon, do hereby make application for a certificate of registration as evidence of a right to appropriate ground water.

1. Source from which water is withdrawn is pump wells
(Flowing well, pump well, infiltration trench, or tunnel)

2. Location is: See map attached
(Approximate distance and direction from nearest city or town)

and is more particularly described as follows:

(a) See map attached
(Give distance and bearing to corner of section or other legal subdivision)

being within NE 1/4 NW 1/4 of Sec. 22, Twp. 27 S, Rge. R. 2 W
(Smallest legal subdivision) (N. or S.) (E. or W.)

or (b) within limits of recorded platted property, town or city:

in Lot _____ Block _____ of _____
(Name of plat or addition)

County of _____
(If within city or town, give name)

3. Construction Work was begun on _____; was completed on #1 well - June 1925
#2 " " 1952
#3 " " 1955
(Date) (Date)

and the ground water claimed was first used for the purposes set out below on _____
(Date)

since which time the water has been used continuously
(Continuously or Intermittently)

from above dates to date
(Date) (Date)

4. Quantity of water claimed and used is #1 - 15
#2 - 45 gallons per minute; _____ acre
#3 - 35 feet per year. 95 g.p.m.

5. Purpose or Purposes for which water is used domestic and irrigation

(Domestic, irrigation, municipal, manufacturing, industrial, etc.)

6. Description of Well: Depth #1 - 36" #2 - 70' feet. Type #1 dug; #2 & #3 drilled
(Dug or drilled)

diameter #2 - 6" inches. Elevation of ground at well site 1250 feet, mean sea level.
#3 - 6" #1 - 6' #3 - 13'
(As near as known)

Depth to water table #2 - 12' feet.
#1 - 95' #1 - 2'

7. Capacity of Well: #2 - 45 g.p.m. with #2 - 30' feet drawdown.
#3 - 35 g.p.m. with #3 - 40' feet drawdown.

Date of test When finished

If Flowing Well: Measured discharge _____ g.p.m. on _____
(Date)

Shut-in pressure at ground surface _____ lbs. per sq. in. on _____
(Date)

Water is controlled by _____
(Cap, valve, etc.)

8. Casing: (Give diameter, commercial specifications and depth below ground surface of each casing size.)

#1 - 36 inch diameter concrete pipe from 0 to 18' feet
 #2 - 6 inch diameter steel casing from 0 to 20' feet
 #3 - 6 inch diameter " " from 0 to 20' feet
 inch diameter from to feet

Describe and show depth of shoe, plug, adapter, liner or other details:

9. Perforated Casings or Screens:

None from to
 (Number per foot and size of perforations, or describe screen)
 from to
 from to
 from to

10. Log of Well: (Describe each stratum or formation clearly, indicate if water bearing, and give thickness and depth as indicated.)

MATERIAL	Thickness (Feet)	Depth to Bottom (Feet)
#1 - 6' of black sandy loam		
12' of granite sand and loam to hardpan		
#2 - Same as #1 to 20' hardpan, sandstone & granite		50'
#3 - " " " " " " " " " "		80'

If log of well is not available, give name and address of driller.

11. Infiltration Trench: Covered or open None

Dimensions: Length ft. Minimum depth ft. Maximum depth < ft.

Bottom width ft. Discharge g.p.m. Date of test

12. Tunnel: Type of lining > None

Dimensions:
(Length, course, and cross sectional size)

Position of water bearing stratum with reference to portal of tunnel

Log of tunnel: (Preceding table for log of well may be used, if desired. Give footage from portal and character of materials, as pertinent.)


- #1 - 1" x 3/4" Pacific Pump Co. Mod. N 8 BF
- 13. Pumping Equipment: #2 - Pacific Beresford Submersible Mod. 7 A, 22-2
- #3 - Jacuzzi Bros. Inc. Jet Pump 3VHHE-WGD 23
- (a) Pump #1 - 1 HP 220 V (Make, type and size) Capacity g.p.m.
- (b) Motor #2 - 2 HP " (Type and horsepower)
- #3 - 3 HP " (Type and horsepower)

14. Location of area irrigated or to be irrigated, or place of use if for purposes other than irrigation.

Township North or South	Range E. or W. of Willamette Meridian	Section	Forty-acre Tract	Number Acres To Be Irrigated	Date of Reclamation	
See description on map attached.						1925
				(32.7 acres)	1952	
T37S	R2W	22	NE 1/4 of NW 1/4	12	1955	
"	"	15	SE 1/4 of SW 1/4	20.7	1958	

15. If the ground water supply is supplemental to an existing water supply, identification of any application for a permit, permit, certificate or adjudicated right to appropriate water made or held by the registrant.

Township 37S Range R. 2 W, W.M.
North

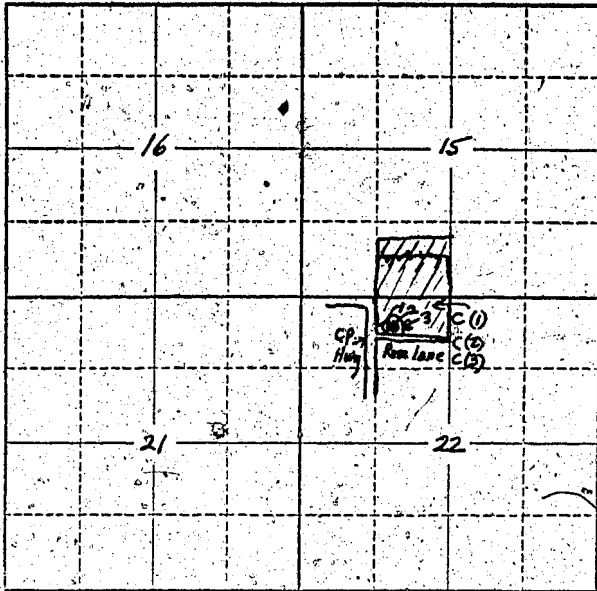

Locate well and acreage of irrigated land on plat.

Scale: 2" = 1 Mile

STATE OF OREGON

County of Jackson

ss.

I, J. C. Boyle, being first duly sworn, do hereby certify that I have read the foregoing Registration Statement and that all of the items therein contained are true to the best of my knowledge and belief.

J. C. Boyle
(Signature of Registrant)

Subscribed and sworn to before me this 1st day of September, 1955

My commission expires Jan. 20, 1957

[Signature]
(Notary Public)

(SEAL)

CERTIFICATE OF REGISTRATION

STATE OF OREGON

County of Marion

ss.

This is to certify that the foregoing Registration Statement was received in the office of the State Engineer on the 2nd day of September, 1955, at 8:00 o'clock A. M. and has been duly recorded in said office in Book No. 1 of Registration Statements on page 6.

Construction shall be completed by 15 1955, and the water completely applied to beneficial use by 15 1955.

Witness my hand this 24th day of February, 1956

Lewis A. Stanley
(State Engineer)

By _____ (Deputy)