

RECEIVED
STATE ENGINEER
SALE OREGON

REGISTRATION NO. GR-70
CERTIFICATE NO. GR-60

Registration Statement

OF CLAIMANT OF RIGHT TO APPROPRIATE GROUND WATER

(Under Chapter 708, Oregon Laws 1955.)

TO THE STATE ENGINEER OF OREGON:

I, Oliver E. Lutz

of Hillsboro Rt 1 Box 225 County of Washington.

State of Oregon, do hereby make application for a certificate of registration as evidence of a right to appropriate ground water.

1. Source from which water is withdrawn is Pump Well
(Flowing well, pump well, infiltration trench, or tunnel)

2. Location is: 5 miles from Hillsboro
(Approximate distance and direction from nearest city or town)

and is more particularly described as follows:

(a) 875 feet north and 400 feet west from SE corner Section 22 T1N, R1W
(Give distance and bearing to corner of section or other legal subdivision)
being within Ref Lots 9 & 10 SE 1/4 of Sec. 22, Twp. 1 N, Rge. 2 W
(Smallest legal subdivision) (N. or S.) (E. or W.)

or (b) within limits of recorded platted property, town or city:

in Lot _____, Block _____ of _____
(Name of plat or addition)

County of _____
(If within city or town, give name)

3. Construction Work was begun on 7-8-55; was completed on 7-20-55
(Date) (Date)

and the ground water claimed was first used for the purposes set out below on 8/25/55 to 9/18/55
(Date)

since which time the water has been used Intermittently
(Continuously or intermittently)

from Aug. 25, 1955 to Sept 18, 1955
(Date) (Date)

4. Quantity of water claimed and used is 35 gallons per minute; 10 acre feet per year.

5. Purpose or Purposes for which water is used Irrigation

(Domestic, irrigation, municipal, manufacturing, industrial, etc.)

6. Description of Well: Depth 200 feet. Type Drilled
(Dug or drilled)
diameter 8" I.D. inches. Elevation of ground at well site 200' feet, mean sea level.
(As near as known)

Depth to water table 18 feet.

7. Capacity of Well: 35 g.p.m. with 142 feet drawdown.

_____ g.p.m. with _____ feet drawdown.


Date of test 7-20-55

If Flowing Well: Measured discharge _____ g.p.m. on _____
(Date)

Shut-in pressure at ground surface _____ lbs. per sq. in. on _____
(Date)

Water is controlled by Valve
(Cap, valve, etc.)

Township 1 N Range 2 W, W.M.
North

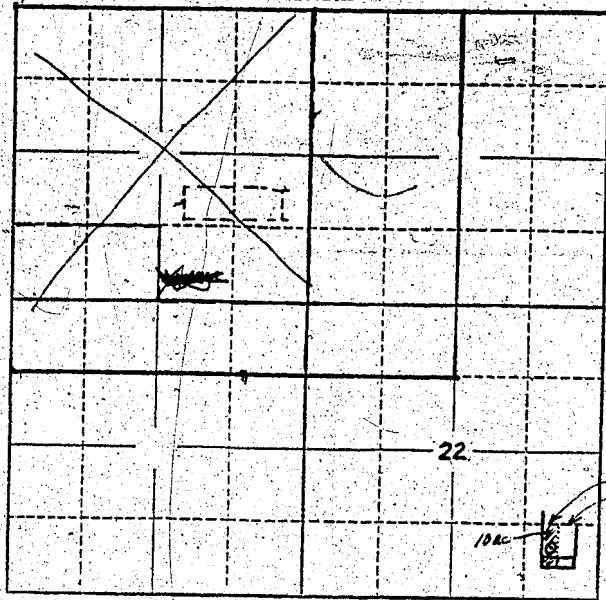

Locate well and acreage of irrigated land on plat.

Scale: 2" = 1 Mile

STATE OF OREGON

County of Washington

ss.

I, Oliver E. Lutz, being first duly sworn, do hereby certify that I have read the foregoing Registration Statement and that all of the items therein contained are true to the best of my knowledge and belief.

Oliver E. Lutz

(Signature of Registrant)

Subscribed and sworn to before me this 28 day of December, 1955

My commission expires Sept 24, 1958

Flange to Shoup

(Notary Public)

(SEAL)

NOTARY PUBLIC FOR OREGON
My Commission Expires Sept. 24, 1958

CERTIFICATE OF REGISTRATION

STATE OF OREGON

County of Marion

ss.

This is to certify that the foregoing Registration Statement was received in the office of the State Engineer on the 3rd day of January, 1956, at 8:00 o'clock A.M. and has been duly recorded in said office in Book No. 1 of Registration Statements on page 60

Construction shall be completed by 1, 1956, and the water completely applied to beneficial use by 10, 1956

Witness my hand this 24th day of February, 1956

Lewis A. Stanley
(State Engineer)

By

(Deputy)