

# Registration Statement

## OF CLAIMANT OF RIGHT TO APPROPRIATE GROUND WATER

TO THE STATE ENGINEER OF OREGON:

I, Wendell P and Evelyn M Wick  
of 3291 Arrowhead Dr Eugene, Oregon County of Jane  
(Mailing address)

State of Oregon do hereby make application for a certificate of registration as evidence of a right to appropriate ground water.

1. Source from which water is withdrawn is 1 - Pump Well  
(Flowing well, pump well, infiltration trench, or tunnel)

2. Location is: 6 mi NW of Eugene Oregon  
(Approximate distance and direction from nearest city or town)

and is more particularly described as follows: 970 feet West and 600 feet South from NE 1/4 of section 10.

(Give distance and bearing to corner of section or other legal subdivision)  
being within Wickman Park Division and Claim #51 of Sec. 10, Twp. 17 S, Rge. 4 W-WM  
(Smallest legal subdivision) (N. or S.) (E. or W.)

or (b) within limits of recorded platted property, town or city:

in Lot \_\_\_\_\_, Block \_\_\_\_\_ of \_\_\_\_\_  
(Name of plat or addition)  
County of \_\_\_\_\_  
(If within city or town, give name)

3. Construction Work was begun on May 15, 1955; was completed on May 16, 1955  
(Date) (Date)

and the ground water claimed was first used for the purposes set out below on May 1955  
(Date)

since which time the water has been used intermittently  
(Continuously or intermittently)

from May 1955 to Oct 1957  
(Date) (Date)

4. Quantity of water claimed and used is 220 gallons per minute; 2.416 acre feet per year.

5. Purpose or Purposes for which water is used irrigation  
(Domestic, irrigation, municipal, manufacturing, industrial, etc.)

6. Description of Well: Depth 20 feet. Type Driven Piped Pipe  
(Dug or drilled)  
diameter 3 inches. Elevation of ground at well site 373 feet, mean sea level.  
(As near as known)  
Depth to water table 12 feet.

7. Capacity of Well: 300 g.p.m. with 17.5 feet drawdown.  
200 g.p.m. with 14 feet drawdown.

Date of test May 16, 1955

If Flowing Well: Measured discharge \_\_\_\_\_ g.p.m. on \_\_\_\_\_  
(Date)

Shut-in pressure at ground surface \_\_\_\_\_ lbs. per sq. in. on \_\_\_\_\_  
(Date)

Water is controlled by \_\_\_\_\_  
(Cap, valve, etc.)

8. Casing: (Give diameter, commercial specifications and depth below ground surface of each casing size.)

3 inch diameter from 0 to 25 feet  
 inch diameter from to feet  
 inch diameter from to feet  
 inch diameter from to feet

Describe and show depth of shoe, plug, adapter, liner or other details:

9. Perforated Casings or Screens:

3" well point with 30" of slots from to  
(Number per foot and size of perforations, or describe screen)  
 from to  
 from to  
 from to

10. Log of Well: (Describe each stratum or formation clearly, indicate if water bearing, and give thickness and depth as indicated.)

MATERIAL	Thickness (Feet)	Depth to Bottom (Feet)
Art. gravel		5

If log of well is not available, give name and address of driller.

11. Infiltration Trench: Covered or open

Dimensions: Length \_\_\_\_\_ ft. Minimum depth \_\_\_\_\_ ft. Maximum depth \_\_\_\_\_ ft.  
 Bottom width \_\_\_\_\_ ft. Discharge \_\_\_\_\_ g.p.m. Date of test \_\_\_\_\_

12. Tunnel: Type of lining

Dimensions: \_\_\_\_\_  
(Length, course, and cross section size)

Position of water bearing stratum with reference to portal of tunnel \_\_\_\_\_

Log of tunnel: (Preceding table for log of well may be used, if desired. Give footage from portal and character of materials, as pertinent.)

13. Pumping Equipment:


(a) Pump 7 1/2 HP Cent. Capacity 220 g.p.m.  
(Make, type and size)

(b) Motor \_\_\_\_\_  
(Type and horsepower)

14. Location of area irrigated or to be irrigated, or place of use if for purposes other than irrigation.

Township North or South	Range E. or W. of Williams' s Meridian	Section	Forty-acre Tract	Number Acres To Be Irrigated	Date of Reclamation
17S	4W	10		20 acres	May 1955
"	"	"	NE 1/4 of NE 1/4	12 AC	" "
"	"	"	NW 1/4 of NE 1/4	8 AC	" "
				20 Ac Total	" "

15. If the ground water supply is supplemental to an existing water supply, identification of any application for a permit, permit, certificate or adjudicated right to appropriate water made or held by the registrant.

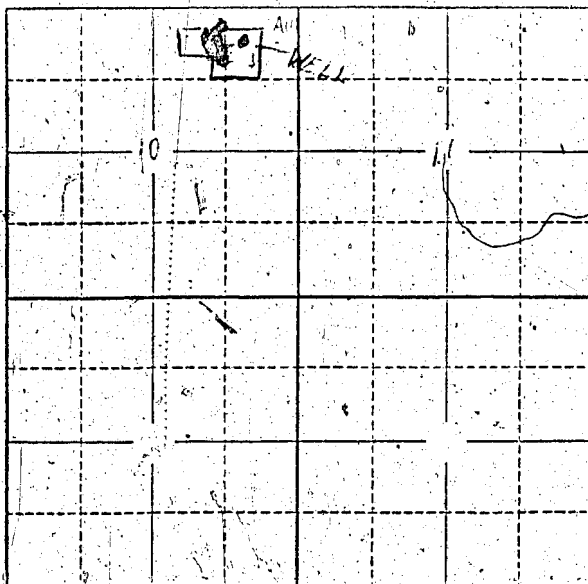

Locate well and acreage of irrigated land on plat.

Scale: 2" = 1 Mile

STATE OF OREGON

County of Clatsop } ss.

I, Wendell P. Wick, being first duly sworn, do hereby certify that I have read the foregoing Registration Statement and that all of the items therein contained are true to the best of my knowledge and belief.

Wendell P. Wick

(Signature of Registrant)

Subscribed and sworn to before me this 28th day of October, 1957

My commission expires My Commission Expires May 19, 1958

Lucas J. Miller

(Notary Public)

(SEAL)

**CERTIFICATE OF REGISTRATION**

STATE OF OREGON

County of Marion } ss.

This is to certify that the foregoing Registration Statement was received in the office of the State Engineer on the 12th day of November, 1957, at 8:00 o'clock A. M. and has been duly recorded in said office in Book No. 4 of Registration Statements on page GR-659 E

Witness my hand this 2nd day of January, 1958

\$15.00

Lewis A. Stanley

(State Engineer)

By \_\_\_\_\_ (Deputy)

GR - 659 C